



T.37S. & 38S., R. 1W., W.M.

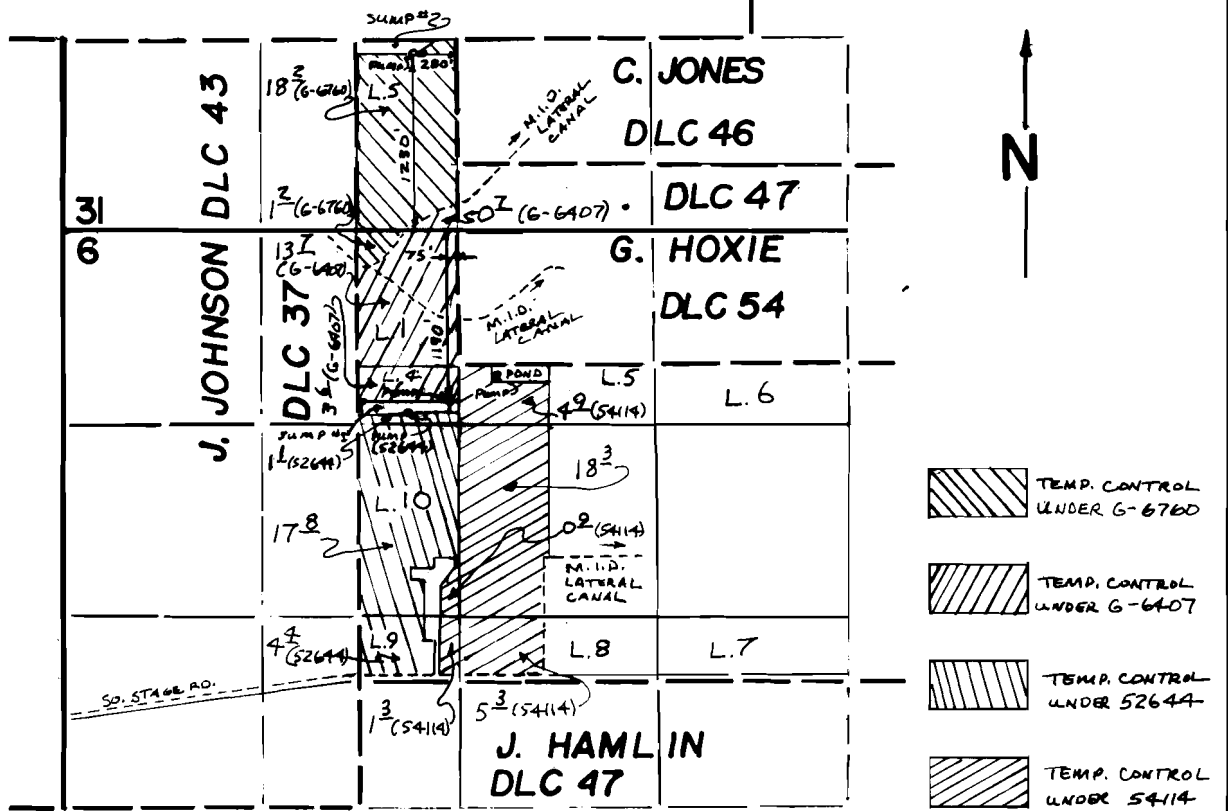

T. 36 S., R. 2 E., W.M.

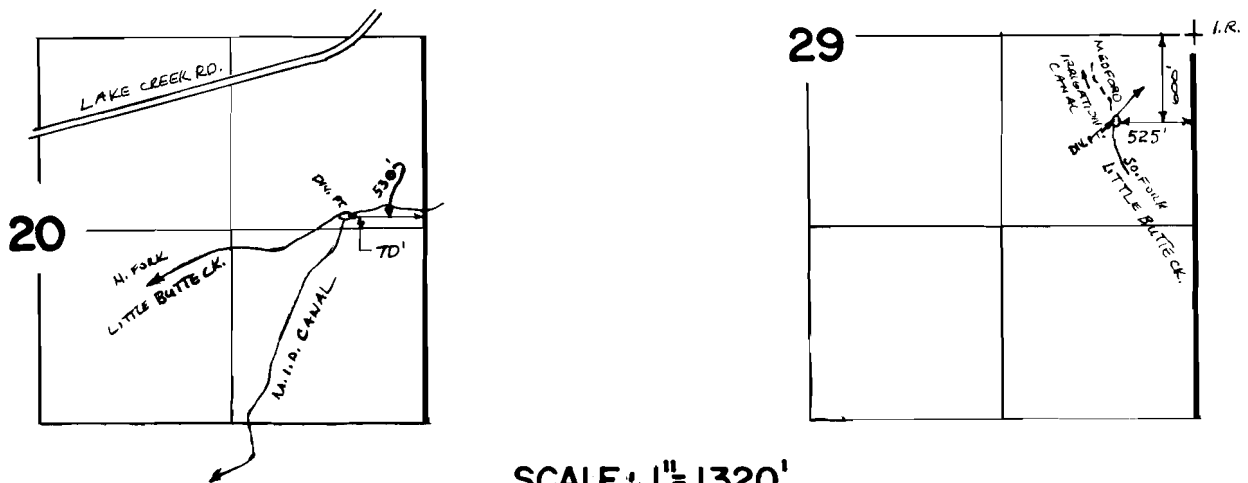

SCALE: 1" = 1320'

FINAL PROOF SURVEY

UNDER 52644

39180

G-6760

G-6280

G-6407

G-5805

Application No. 54114 Permit No. 40510

IN NAME OF

MODOC ORCHARD COMPANY C/O BEN DARRAS

Surveyed MARCH 21 84 by B. S. JAMES