


G-7157  
58657

T. 39 S., R. 19 E., W. M.

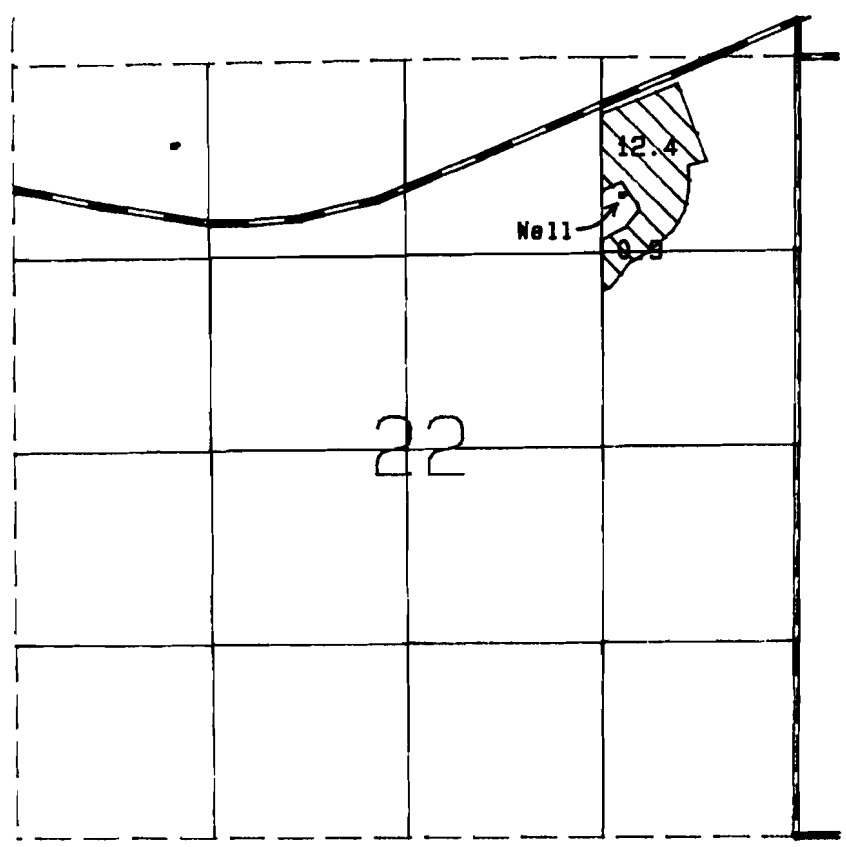

SCALE: 1" = 1320'

WELL LOCATED 920 FT. S. AND 1170 FT. W. FROM NE. SEC. COR. SEC. 22

FINAL PROOF SURVEY  
UNDER

Application No. G-7694 Permit No. G-7157

IN NAME OF  
Larry & Susan Conn

Surveyed Oct. 15, 1987 By T.M. Warren

Photo: 379-98A RMK-619