


T.11S.,R.4W.,W.M.

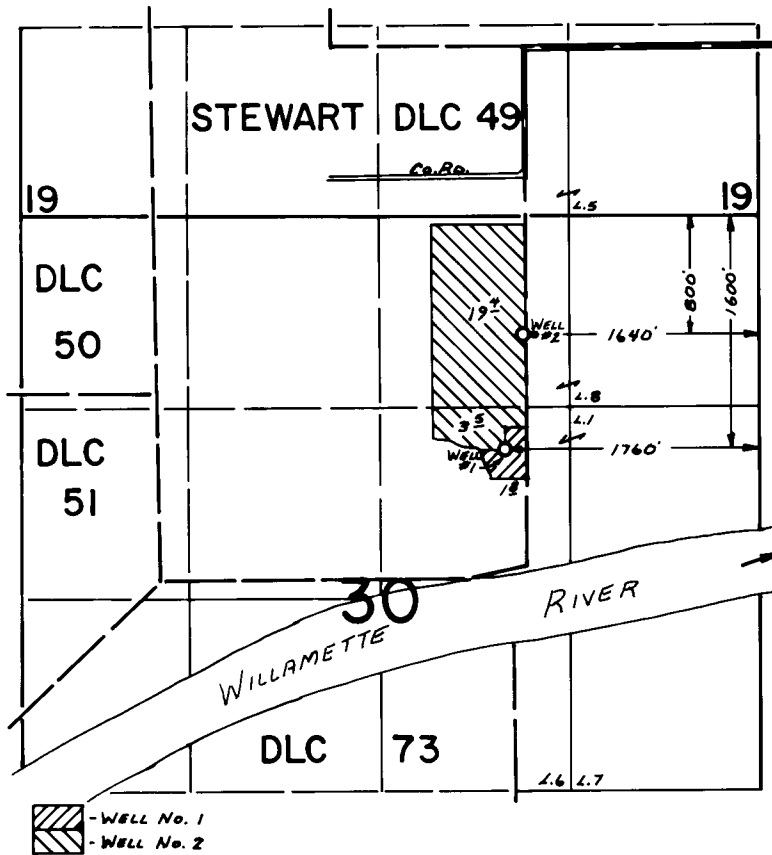

FINAL PROOF SURVEY
UNDER

Application No. ..G:7.756. Permit No. ..G:7.371.....
IN NAME OF

..NONA M. & WILLIAM M. SUNFORD

Surveyed Aug..25... 19.82., by ..L..M..TOLL.....