


map from
file G-8267

T.8S.,R.2W.,W.M.

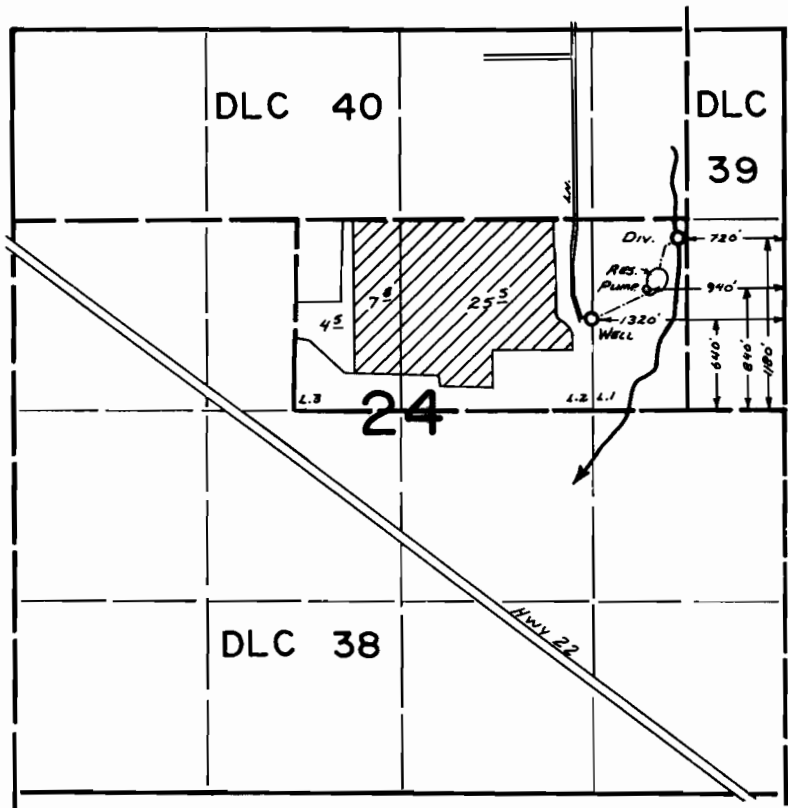

FINAL PROOF SURVEY
UNDER

R-56189 R-6665
56190 42018 (Primary)
Application No. G-8267 Permit No. G-7555 (Supplemental)
IN NAME OF

HERBERT L. & JOYCE M. LITTAU

Surveyed Aug. 11, 1981, by L. TOLL