


T.8S.,R.2W.,W.M.

*map from
file G-8267*

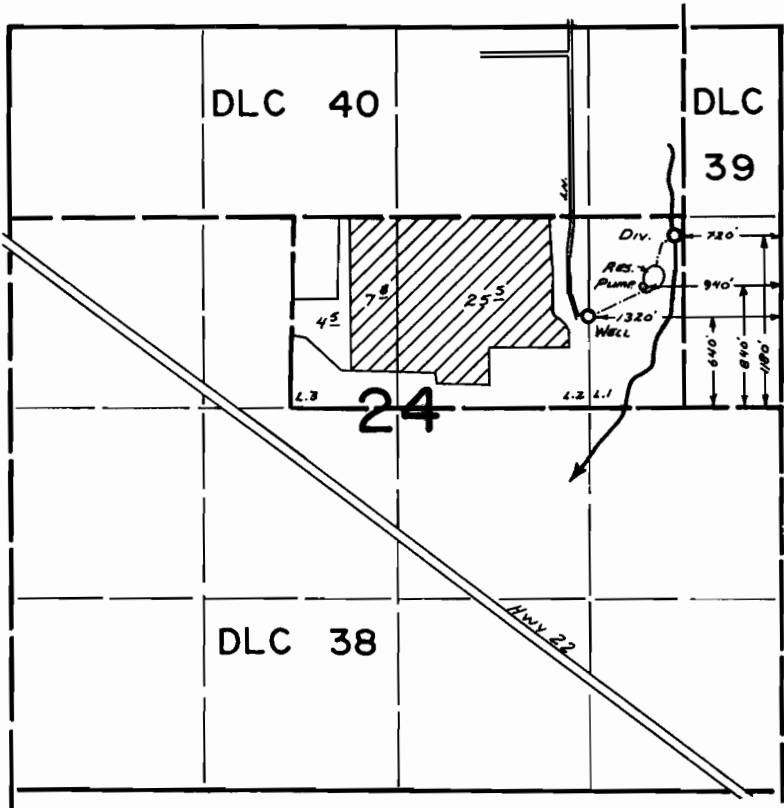

FINAL PROOF SURVEY
UNDER

R-56189	R-6665
56190	42018 (Primary)
Application No. G-8267	Permit No. G-7555 (Supplemental)

IN NAME OF

HERBERT L. & JOYCE M. LITTAU

Surveyed Aug. 11, 1981, by L. TOLL