


T.8S.,R.2W.,W.M.

*map from  
file G-8267*

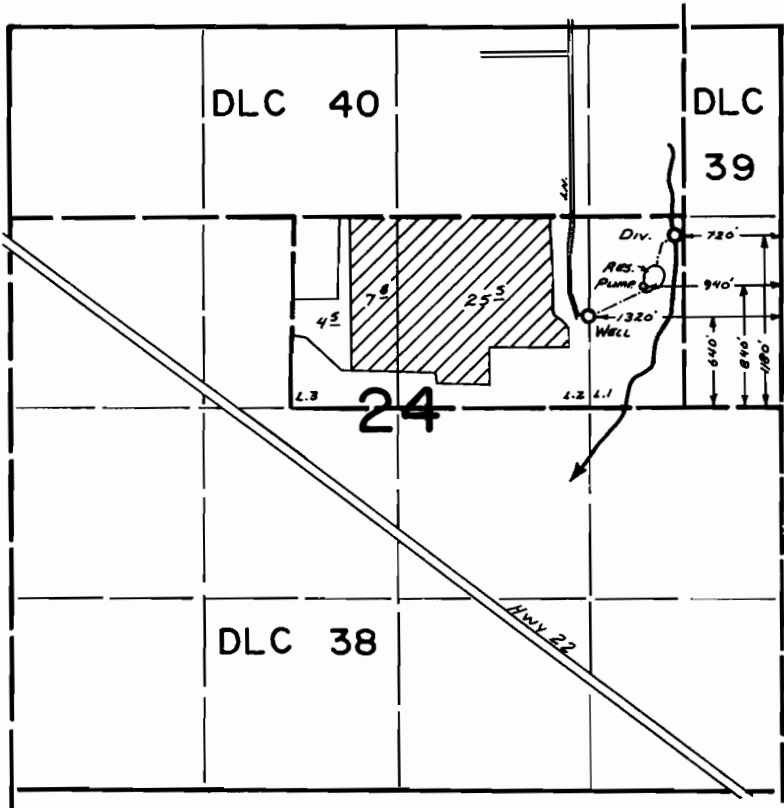

**FINAL PROOF SURVEY**  
UNDER

R-56189	R-6665
56190	42018 (Primary)
Application No. G-8267	Permit No. G-7555 (Supplemental)

IN NAME OF

**HERBERT L. & JOYCE M. LITTAU**

Surveyed Aug. 11, 1981, by L. TOLL