
G- 7687
5866 S

T. 2N., R. 22 & 23E., W.M.

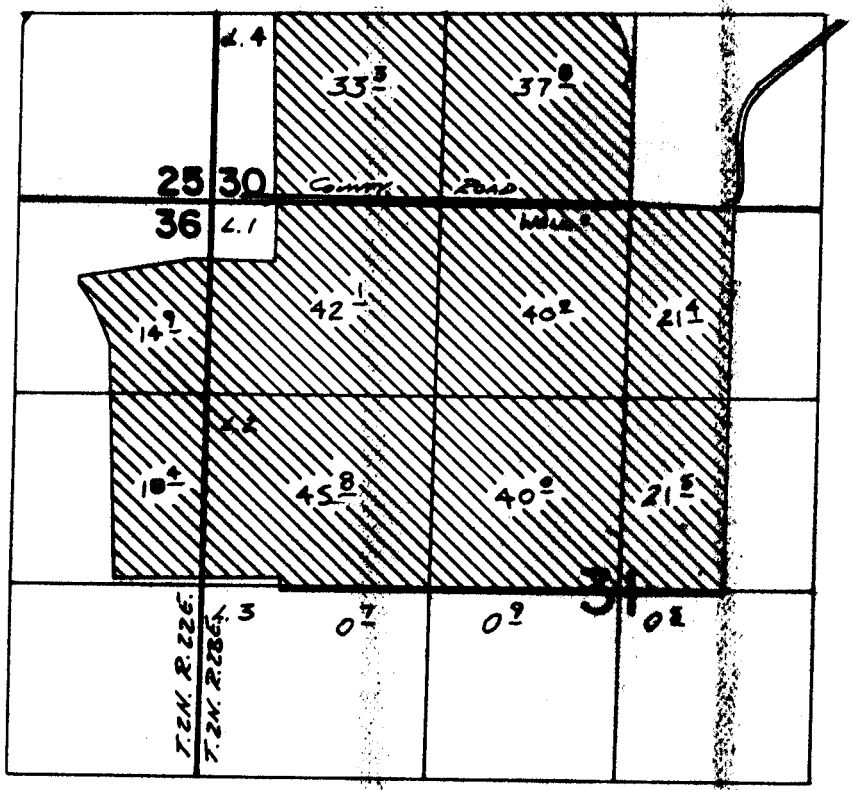

Well Loc: 90'S. & 2560'E. From NW Cor. Sec 31

FINAL PROOF SURVEY
UNDER

Application No. G-8519 Permit No. G-7687
IN NAME OF

FAIRVIEW RANCH INC.

Surveyed 8-23 1982, by V.L. Church

49c-60