


T. 39 S., R. 20 E., W.M.

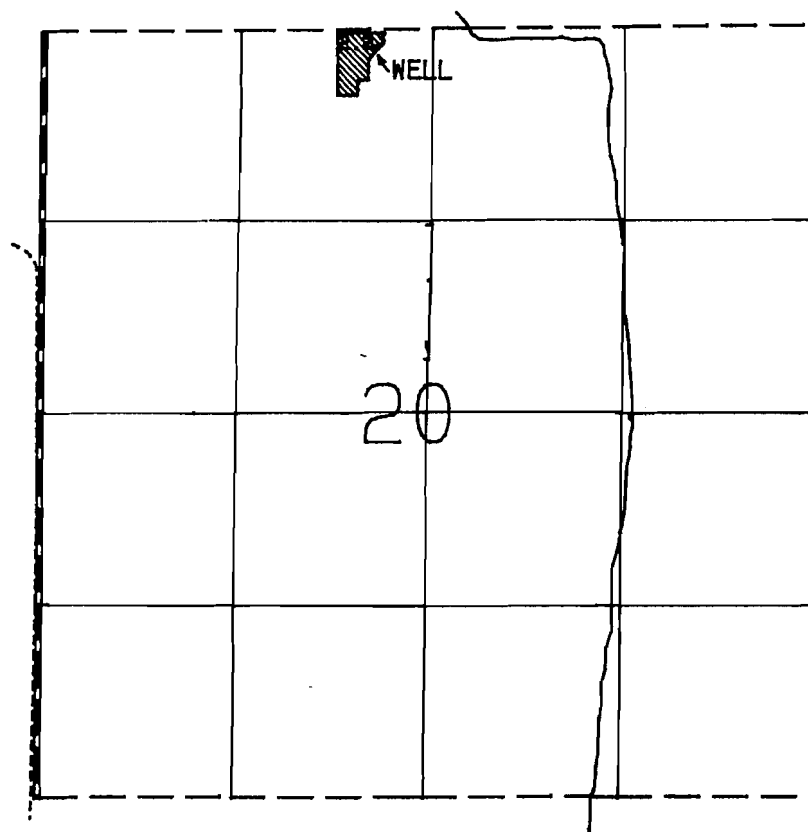

SCALE: 1" = 1320'

WELL LOCATED 100 FT. S. AND 2260 FT. E. FROM NW. COR. SEC. 20

FINAL PROOF SURVEY
UNDER

Application No. G-10587 Permit No. G-9707

IN NAME OF

CLEON AND MARIAN PUETZ

Surveyed Oct. 15, 1987 By V.L. CHURCH

Photo: 379-70L JCL-GIS