


T.40 S., R.20 E., W.M.

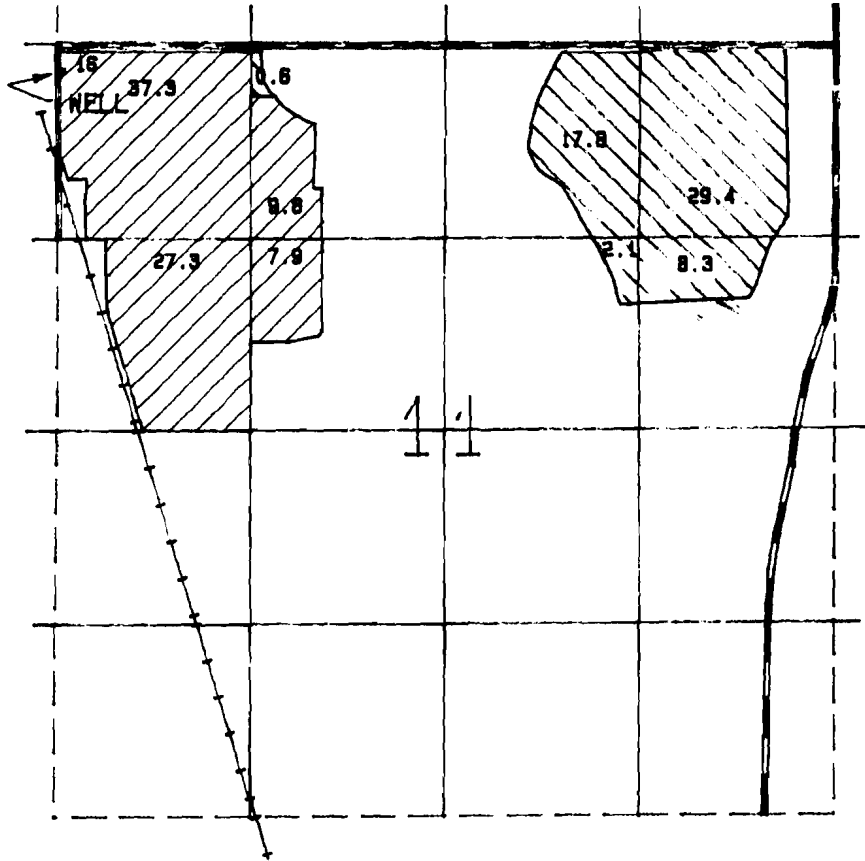

SCALE: 1" = 1320'



PRIM.



SUPP.

WELL LOCATED 170 FT. S. AND 30 FT. E. FROM N.W. COR. SEC. 11

FINAL PROOF SURVEY
UNDER

APPLICATION NO. G-11163 PERMIT NO. G-10371

IN NAME OF

JOHN GAREE

Surveyed Oct. 15, 1987 By V.L. CHURCH

Photo: 379-167D JCL