


T. 35 S., R. 2 E., W.M.

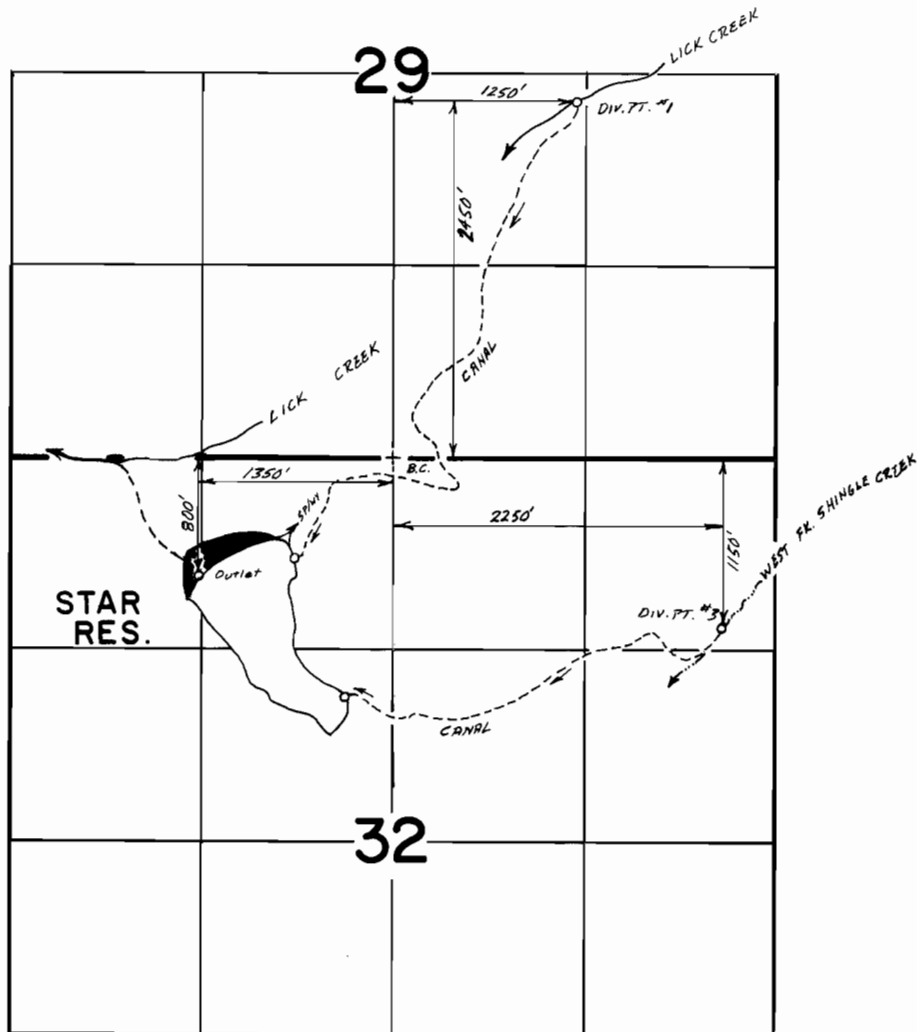

Scale 1"=1320'

FINAL PROOF SURVEY
UNDER

Application No. R-37819 Permit No. R-2999
IN NAME OF

FRANCES JOAN ADAMS JENSEN

Surveyed Sept. 8, 1986, by B.S. JAMES