


# T. 35 S., R. 1 E., W. M.

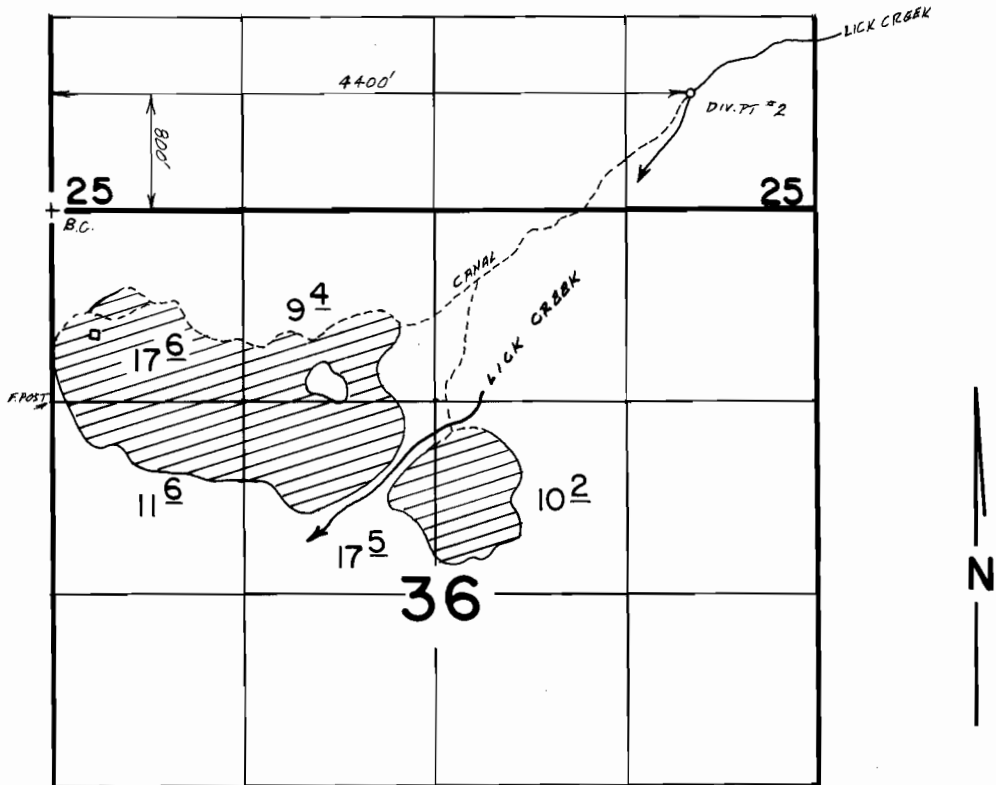

Scale 1"=1320'

## FINAL PROOF SURVEY UNDER

Application No. 37820. Permit No. 28160.....  
IN NAME OF

FRANCES JOAN ADAMS JENSEN

Surveyed Sept. 8, 1986, by B.S. JAMES