


T.6S.,R.6W.,W.M.

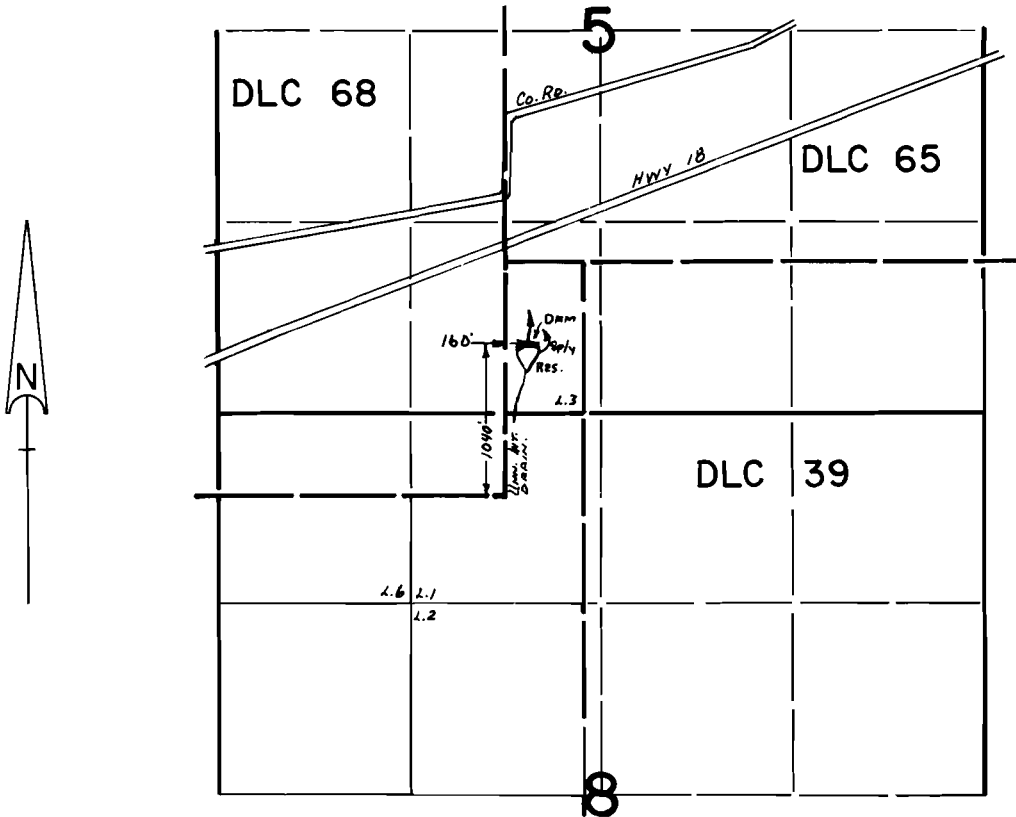

SCALE: 1" = 1320'

FINAL PROOF SURVEY
UNDER

Application No. ~~R-5394~~ Permit No. ~~R-644~~....
IN NAME OF

.....**DANIEL STUIVENGA**.....

Surveyed Aug. 3, 1983, by L.M. JOLL.....