


# T.1N., R.1W., W.M.

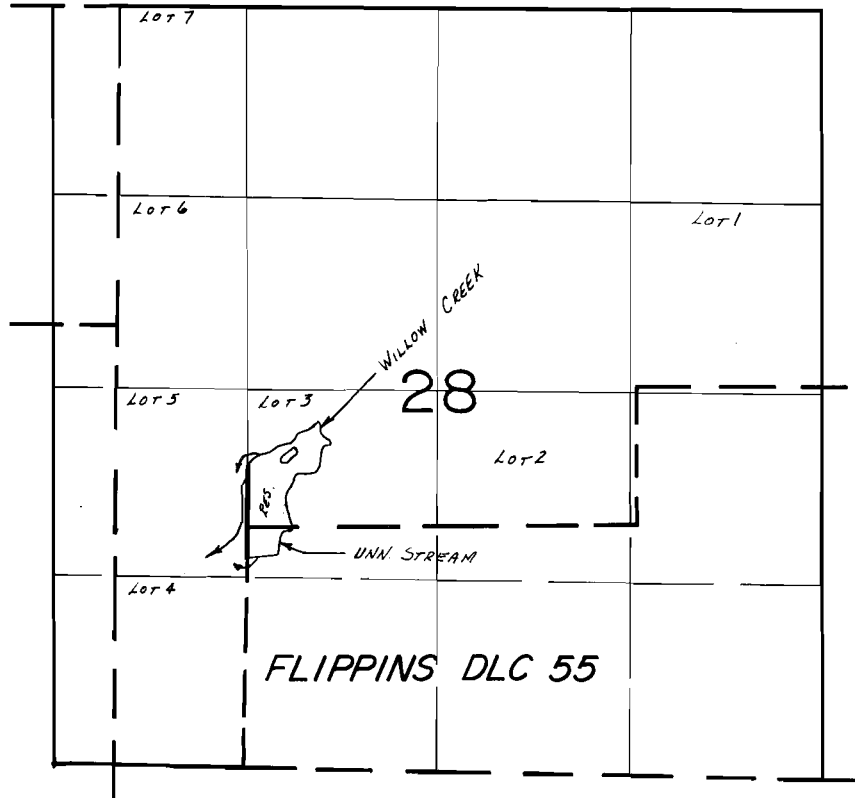

*Div. Pt. Loc.: 1760' N. & 1320' E. FROM SW COR. SEC. 28*

SCALE: 1" = 1320'

## FINAL PROOF SURVEY UNDER

R-55842                      R-6582  
Application No. 55843    Permit No. 41552.....  
IN NAME OF

.....E. J. STRANDBERG.....

Surveyed Aug. 22, 19.84, by B.W. BISHOP.....