


T.1N., R.1W., W.M.

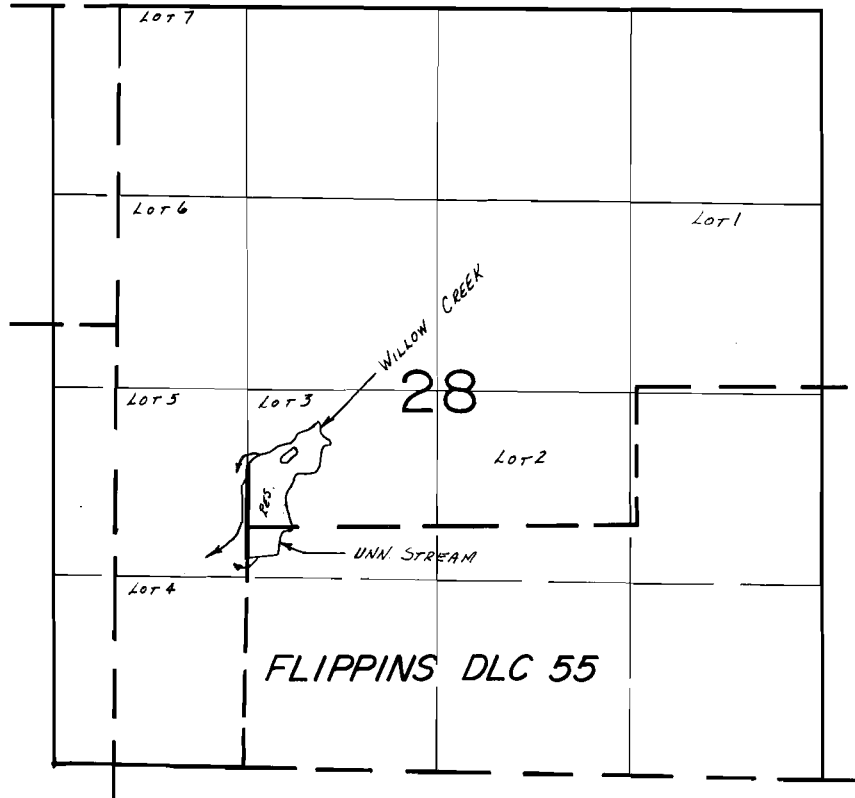

Div. Pt. Loc.: 1760' N. & 1320' E. FROM SW COR. SEC. 28

SCALE: 1" = 1320'

FINAL PROOF SURVEY UNDER

R-55842 R-6582
Application No. 55843 Permit No. 41552.....
IN NAME OF

.....E. J. STRANDBERG.....

Surveyed Aug. 22, 1984, by B. W. BISHOP.....