


T. 26S., R. 7W., W. M.

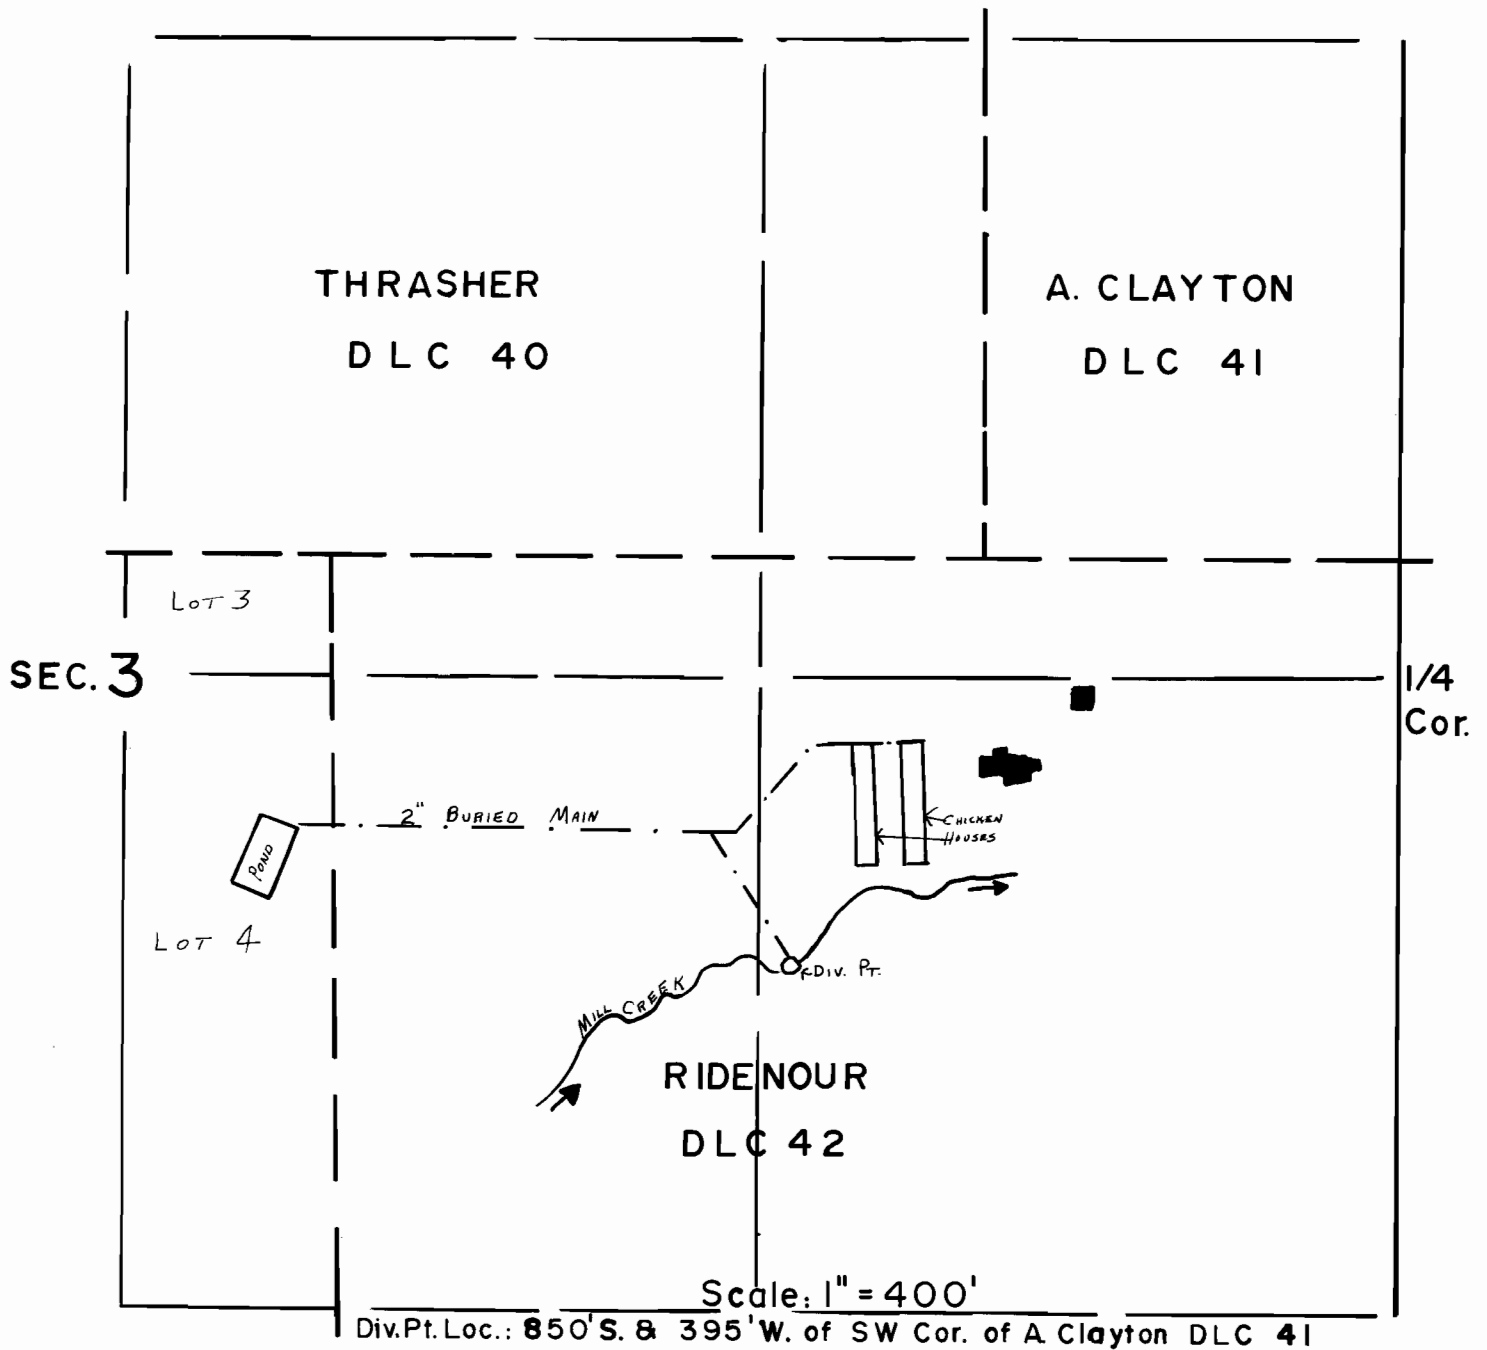

FINAL PROOF SURVEY
UNDER

R-55376 R-7148
Application No. 55377 Permit No. 42957....
IN NAME OF

.....**JOE B. PAULETTO**.....

Surveyed MAY.12... 1982, by ..L.....TOLL.....