


T. 2S., R. 1W., W.M.

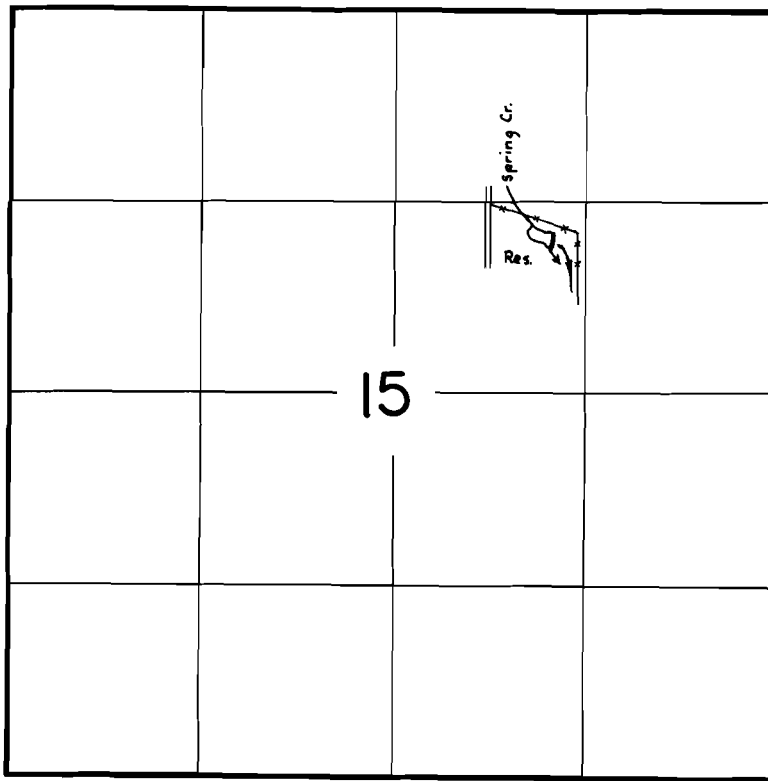

Dam Loc: 1550' S. & 1520' W. fr. N.E. Cor. Section 15

SCALE: 1" = 1320'

**FINAL PROOF SURVEY**  
UNDER

R-57607                      R-7765  
Application No. 58145      Permit No. 43761  
IN NAME OF

**GEORGE U. & MARGARET E. BENZ**

Surveyed NOV. 16, 1983, by L. TOLL