



T.2S., R.5W., W.M.

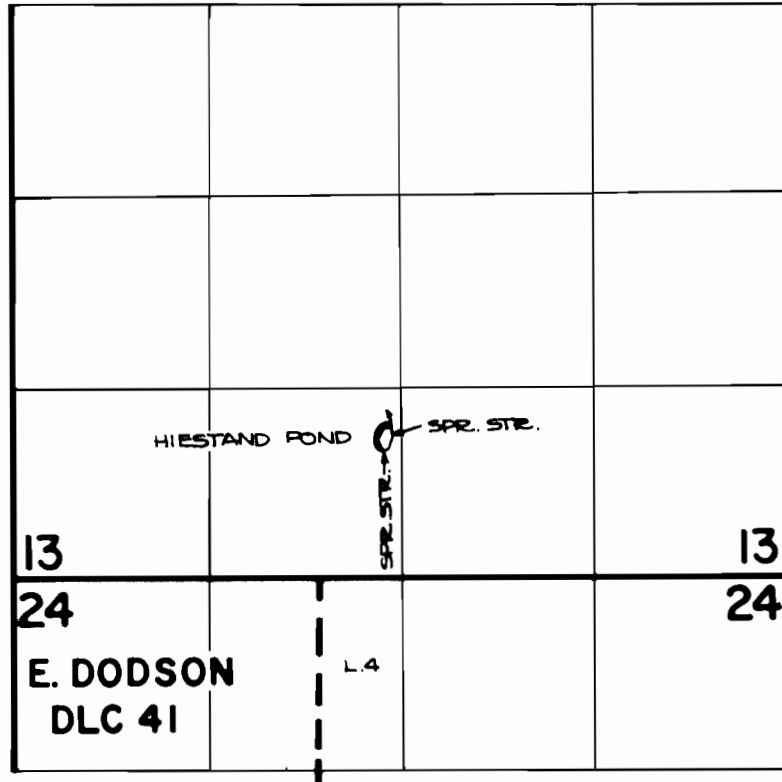

DAM LOCATION: 1000 FT. N. AND 2800 FT. W. FROM THE
S.E. CORNER OF SECTION 13.

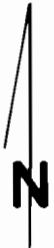

SCALE: 4"=1 MILE

FINAL PROOF SURVEY
UNDER

Application No. R-59435 Permit No. R-7994
IN NAME OF

JOHN F. Hiestand, JR.

Surveyed SEPT. 18, 1984, by P. Pooten