


T. 5S., R. 3E., W.M.

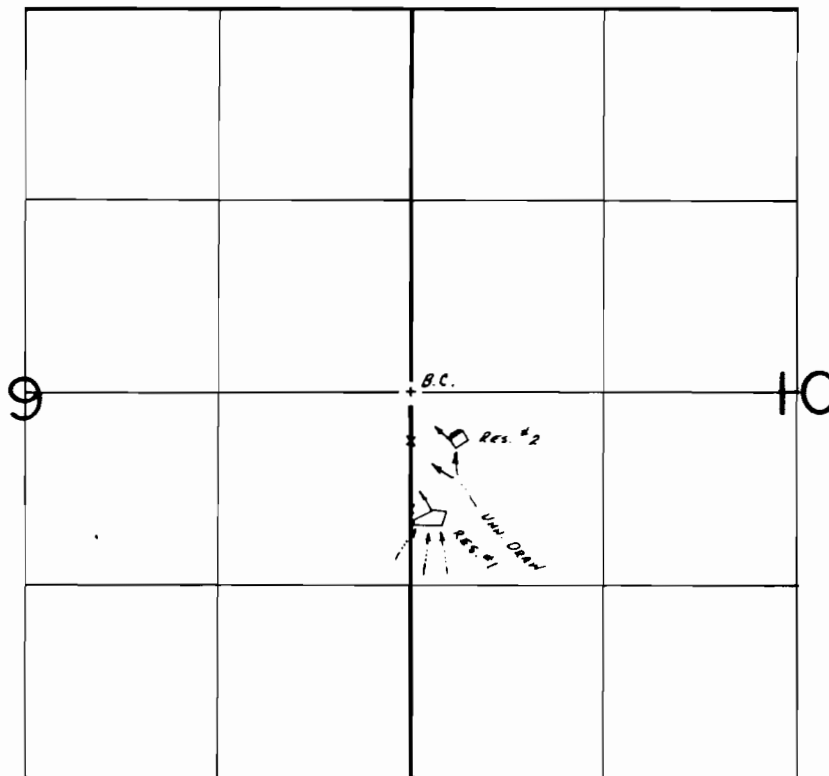

Div. Pts. Loc.: #1- 810'S. & 150'E., #2- 270'S. & 300'E., BOTH FROM N. 1/4 COR. SEC. 10.

SCALE: 1"=1320'

FINAL PROOF SURVEY
UNDER

R-60325 R-8158

Application No. 60326 Permit No. 44964.....

IN NAME OF

.....MICHAEL L. FARKAS.....

Surveyed AUG. 9..... 19.84., by J.R. WOODROOF.....