


T. 5S., R. 3E., W.M.

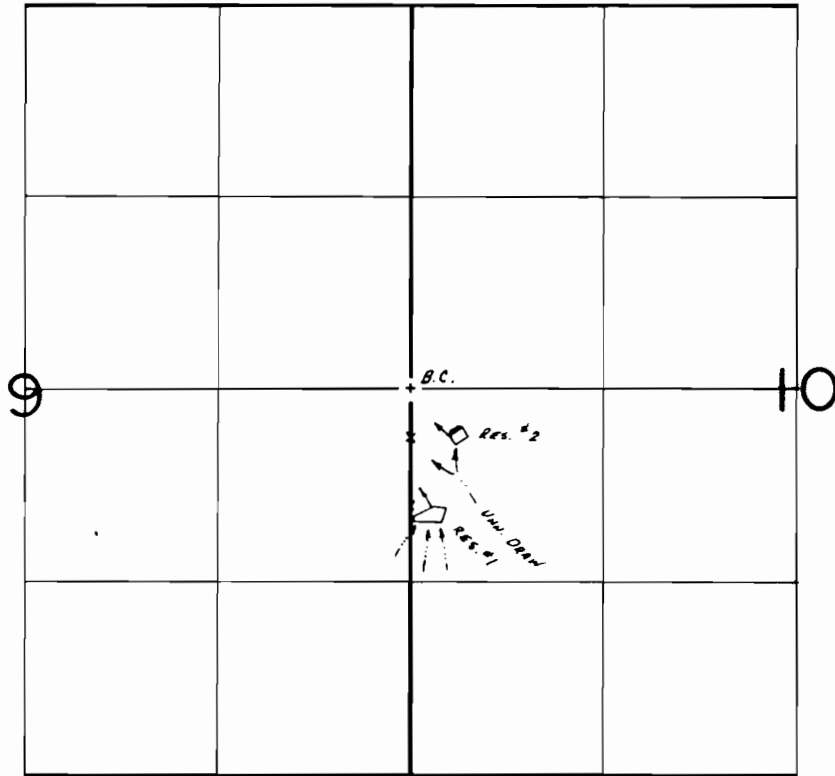

DIV. Pts. LOC.: #1- 810'S. & 150'E., #2- 270'S. & 300'E., BOTH FROM W. 1/4 COR. SEC. 10.

SCALE: 1"=1320'

**FINAL PROOF SURVEY**  
UNDER

R-60325                      R-8158  
Application No. 60326.. Permit No. 44964.....  
IN NAME OF

.....MICHAEL L. FARKAS.....

Surveyed AUG. 9..... 19.84., by J.R. WOODROOF.