


# T.5S., R.3E., W.M.

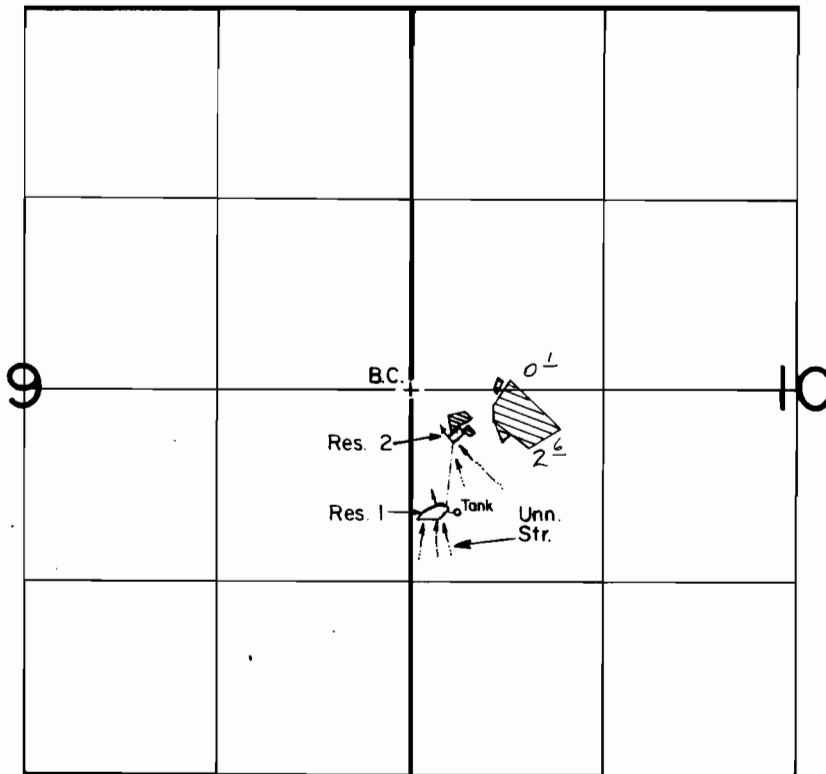

P.O.D.'s Loc.: 1- 810' S. & 150' E., 2- 270' S. & 300' E.,  
both from W. 1/4 Cor. Sec. 10.

Scale : 1" = 1320'

## FINAL PROOF SURVEY UNDER

R-61416

R-8360

Application No. 61417 Permit No. 46455

IN NAME OF

MICHAEL L. FARKAS

Surveyed JUNE 24, 1986, by T. Warren