



T. 4 S., R. 3 W., W. M.

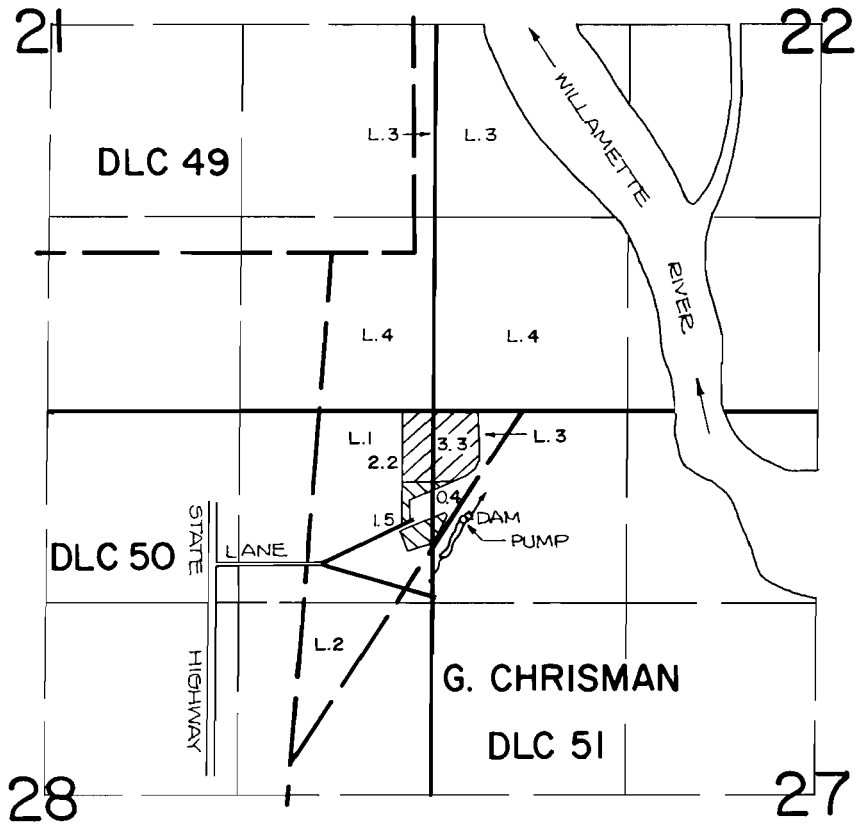

DAM LOCATION: 700 FT. S. AND 250 FT. E. FROM THE N.W. CORNER OF SECTION 27

 PRIMARY  SUPPLEMENTAL

FINAL PROOF SURVEY UNDER


SCALE: 4" = 1 MILE

R-60294 R-8245
Application No. 60295.. Permit No. 45635.....
IN NAME OF

.....THOMAS J. ANDREWS.....

Surveyed MAY..16,.. 1984., by *P. Patten*.....