


T.4S., R.3W., W.M.

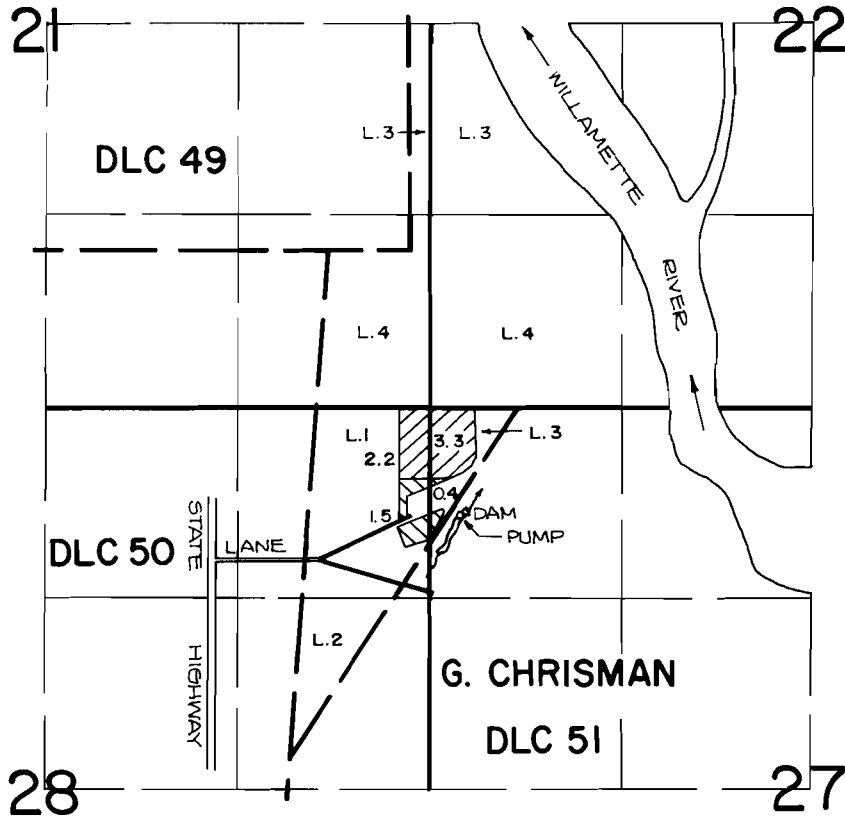

DAM LOCATION: 700 FT. S. AND 250 FT. E. FROM THE N.W. CORNER OF SECTION 27



PRIMARY



SUPPLEMENTAL

FINAL PROOF SURVEY UNDER



SCALE: 4" = 1 MILE

R-60294 R-8245
Application No. 60295.. Permit No. 45635.....
IN NAME OF

.....**THOMAS J. ANDREWS**.....

Surveyed **MAY 16, 1984**, by *P. Patten*.....