


T. 9 S., R. 6 W., W.M.

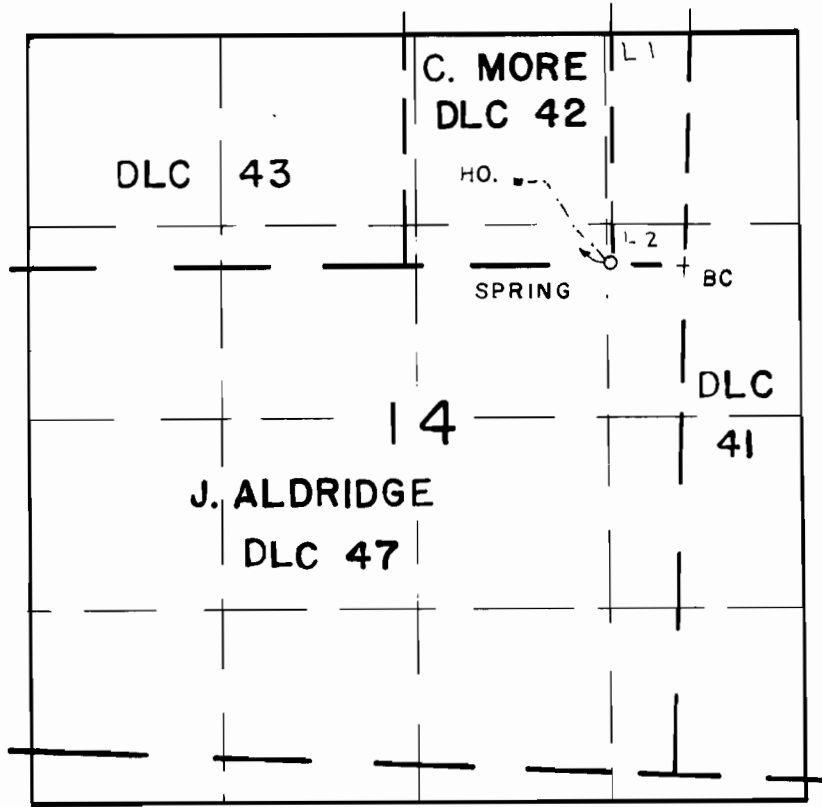

SCALE
1" = 1320'

DIV. PT. LOC. 10' N & 510' W OF NE COR. DLC 47

FINAL PROOF SURVEY UNDER

Application No. 52574 Permit No. 37536
IN NAME OF

DAVID W. PHELPS

Surveyed SEP 4 1984, by P. PAGTER