


T. 1S., R. 43E., W.M.

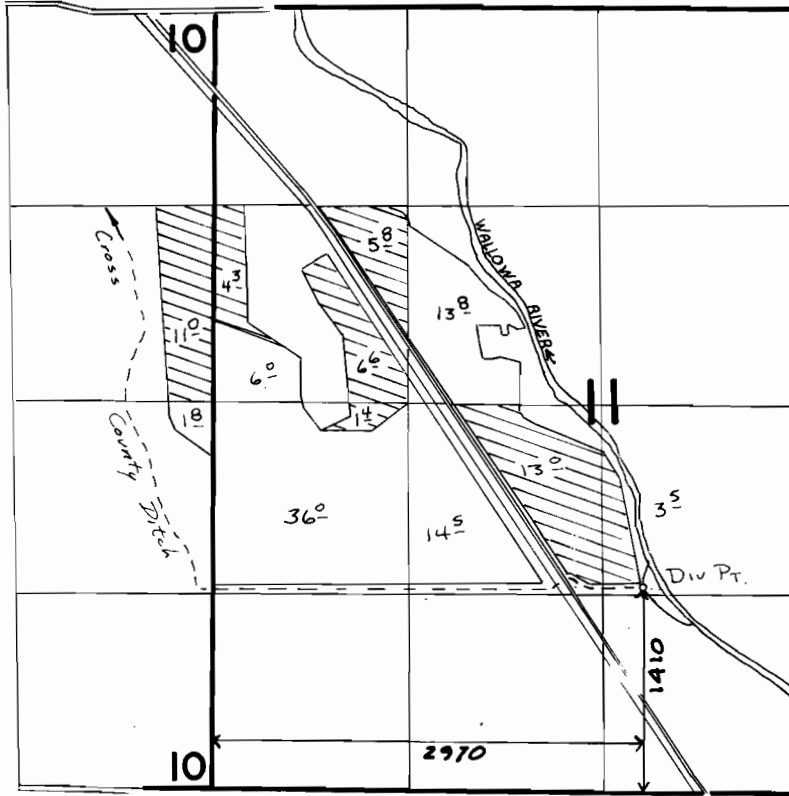

SCALE 1" = 1320'

FINAL PROOF SURVEY

UNDER

TRANSFER 3416

Application No. **51806** Permit No. **41090**

IN NAME OF

GEORGE D. M'DANIEL

Surveyed 8-13 1985, by V.L. Church