


T. 14S., R. 1E., W.M.

Sec. 6

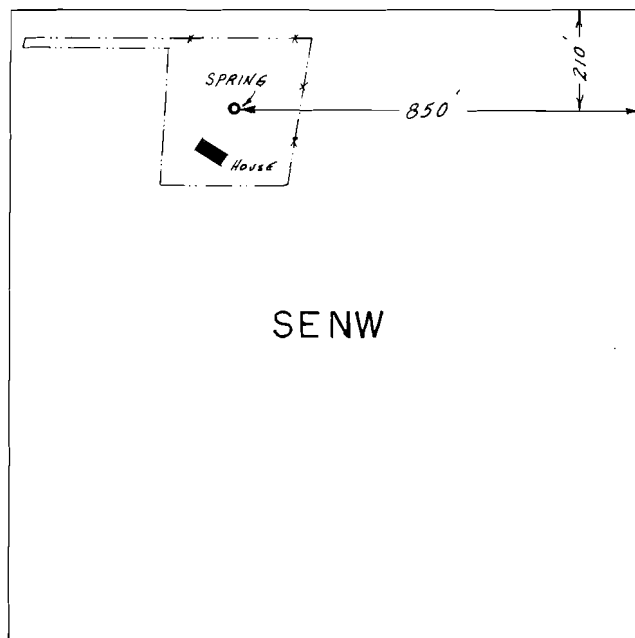

SCALE: 1" = 400'

FINAL PROOF SURVEY
UNDER

Application No. 55924... Permit No. 41992.....
IN NAME OF

.....
Surveyed APR. 23. 19.82, by L. M. TOLL.....

REDRAFT 1-26-88 BWS
PTS 1982-Z & L. D.