


# T. 10S., R. 1E., W. M.

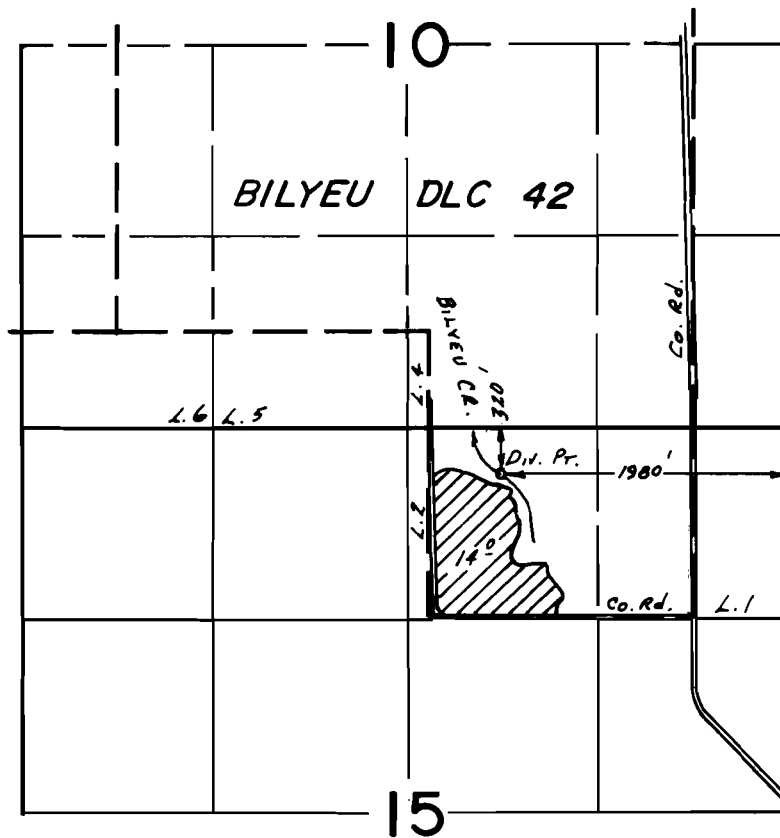

## FINAL PROOF SURVEY UNDER

Application No. 56446.. Permit No. 42305.....  
IN NAME OF

..... LARRY L. SILBERNAGEL .....

Surveyed JUNE 9.... 1982., by L.M. TOLL.....