


T.7S., R.38E., W.M.

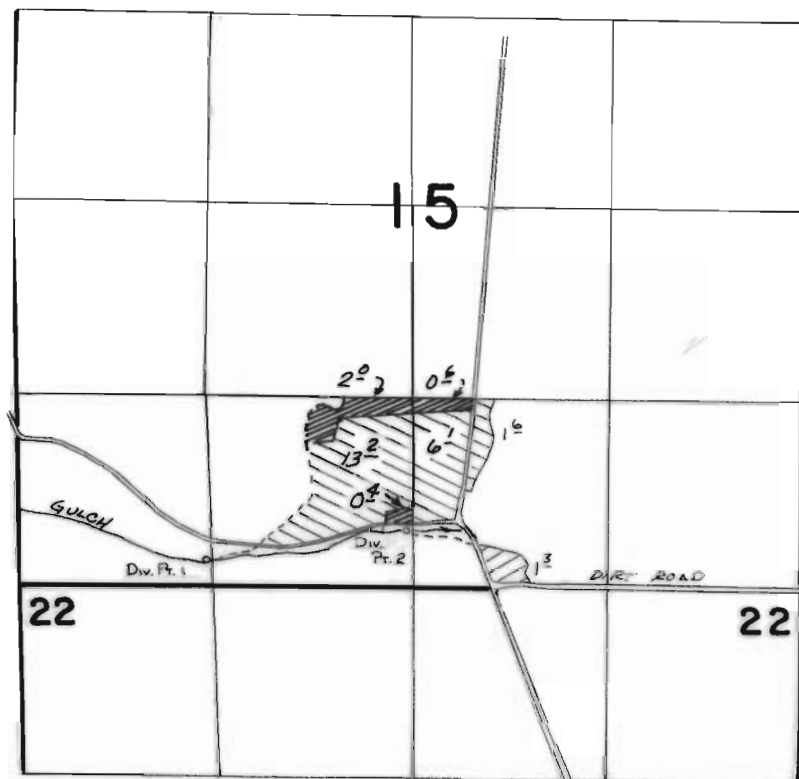

Div. Pt. 1 Loc: 170' N. & 1290' E FROM SW COR. SEC 15

Div. Pt. 2 Loc: 390' N. & 30' W. FROM S 1/4 COR. SEC 15

primary



Div. Pt. 1

Supplemental



Div. Pt. 1



Div. Pt. 2

FINAL PROOF SURVEY UNDER

Application No. **56427** Permit No. **42340**
IN NAME OF

ADELE B. CHANDLER

Surveyed April 16 1982, by N.H. Church