
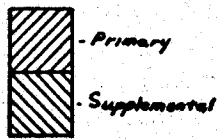


P-42417
58699

T.13S., R.28E., W.M.

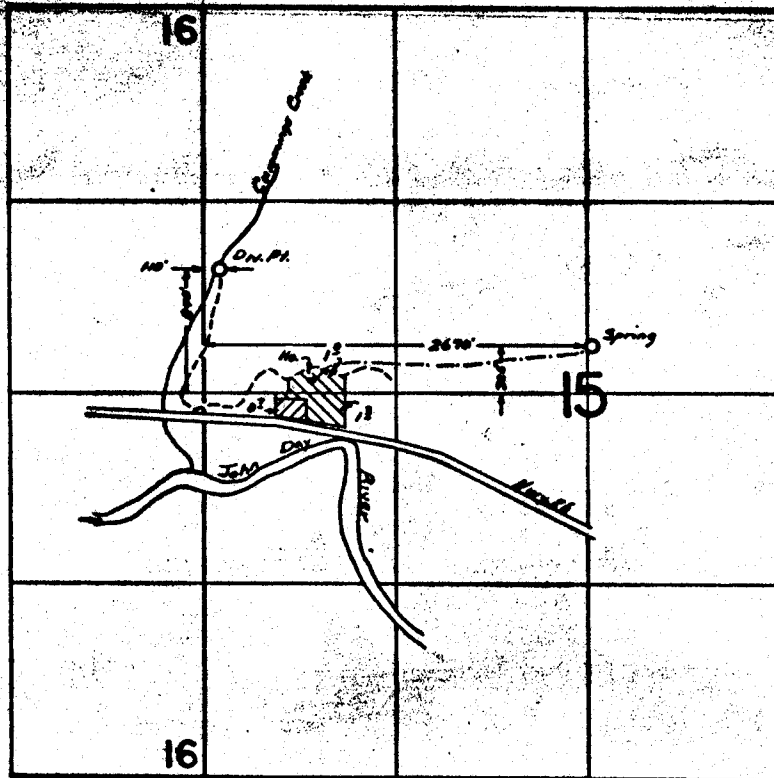

FINAL PROOF SURVEY UNDER

Application No. 56592 42417
59859 Permit No. 45103.....
IN NAME OF

.....JAMES BAY.....

Surveyed Oct. 1, 1981, by S. C. BROWN.....