


T. 6 S., R. 10 W., W.M.

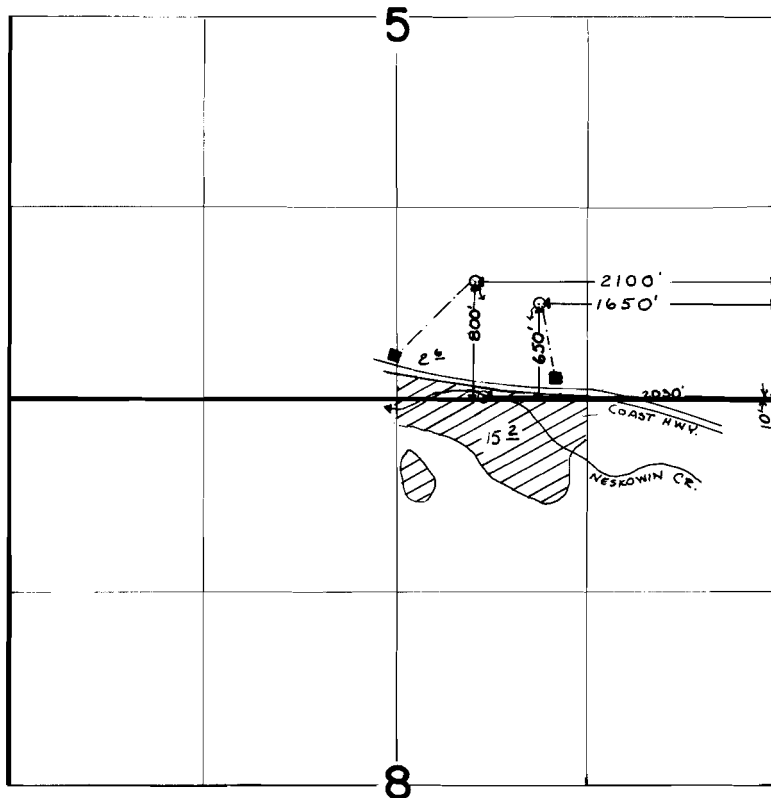

SCALE: 1"=1320'

FINAL PROOF SURVEY
UNDER

Application No. 57790 Permit No. 43438
IN NAME OF

D. JOAN SHUMWAY

Surveyed SEPT. 12, 1984, by P. PAGTER