



T. 33 S., R. 2 E., W. M.

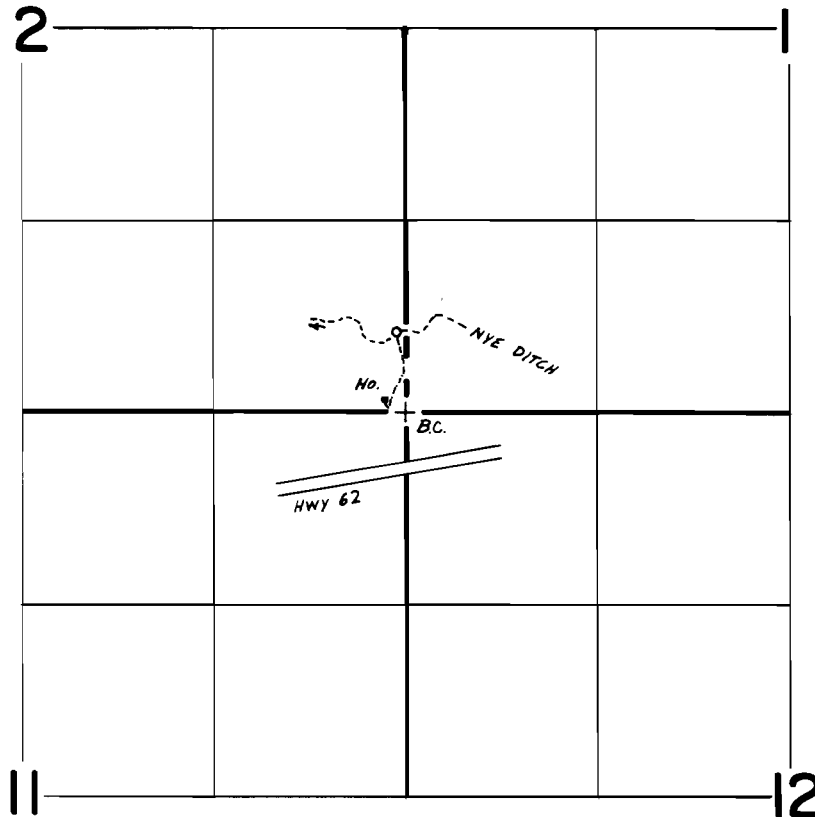

NO. FORK ROGUE RIVER

T. 32 S., R. 3 E.

Scale 1" = 1320'

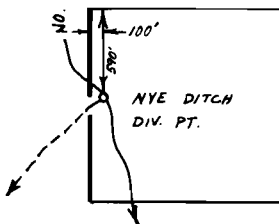

FINAL PROOF SURVEY
UNDER

Sec. 29
NW 1/4 SW 1/4

Application No. 57871... Permit No. 43666.....
IN NAME OF

.....GENE.....C.....WILLIAMS.....

Surveyed May 23, 1983, by B.S. JAMES.....