


T. 40 S., R. 8 & 9 W., W.M.

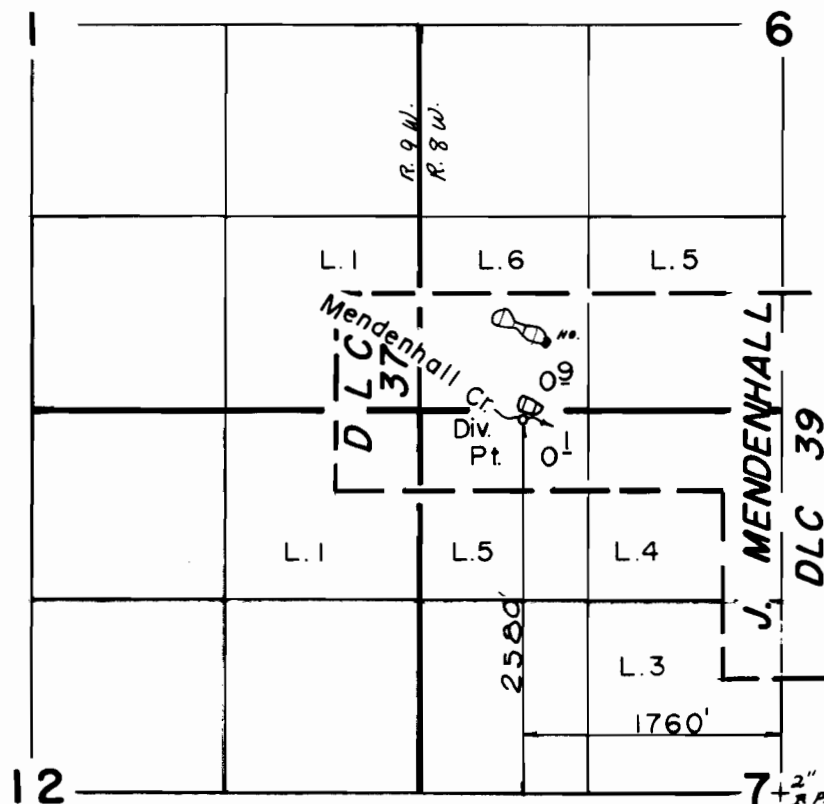

Scale: 1" = 1320'

FINAL PROOF SURVEY UNDER

Application No. **58169** Permit No. **43886**
IN NAME OF

EDWARD L. GOODRICH

Surveyed JUN. 18. 1986, by B. S. JAMES.