


44100

T.3N.,R.10E.,W.M.

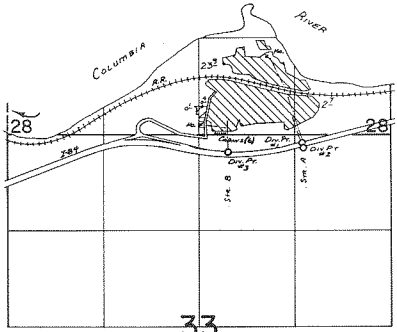

Unk. Str. A - Div 1 - 100 ft S and 1220 ft. W }
 Div 2 - 180 ft S and 1200 ft. W } all from the NE Cor Sec 33
 Unk. Str. B - Div 3 - 240 ft S and 2240 ft W }

FINAL PROOF SURVEY UNDER

Application No. 58317... Permit No. 44100.....
IN NAME OF

JAMES MORTON STRUCK.....

Surveyed Sept. 17... 1982., by J.L.M. TOLL.....

