


T. 1N., R. 4W., W.M.

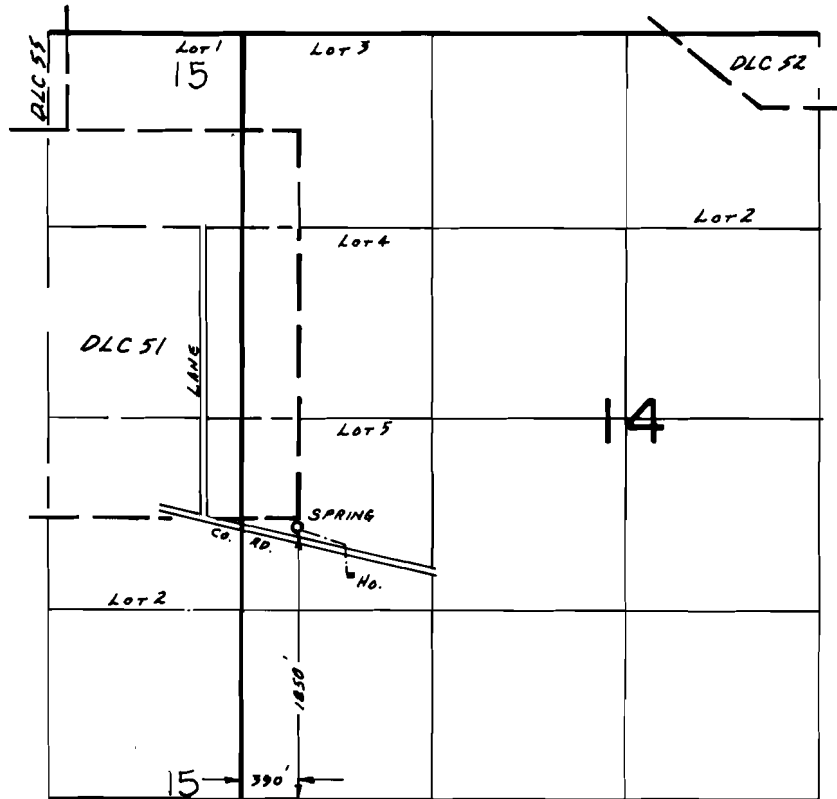

FINAL PROOF SURVEY
UNDER

Application No. 58193 Permit No. 44144
IN NAME OF

JAMES LARRY GIBSON

Surveyed JULY 17, 1980, by R.G. MUCKEN