


T.4S., R.5W., W.M.

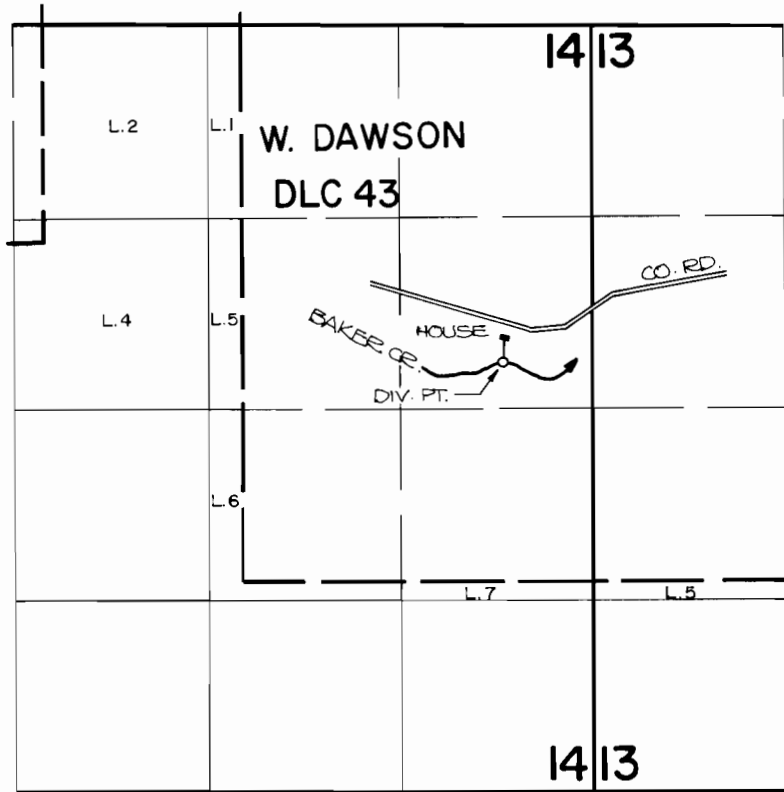

DIV. PT. LOCATION: 2320 FT. S. AND 630 FT. W. FROM THE N.E. CORNER OF SECTION 14.



SCALE: 4" = 1 MILE

FINAL PROOF SURVEY UNDER

Application No. 58590 Permit No. 44309
IN NAME OF

.....**LYLE FARROW**.....

Surveyed JULY 25, 1984, by *P. Patten*.....