
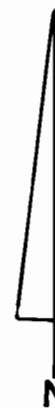


T. 3 N., R. 10 W., W.M.

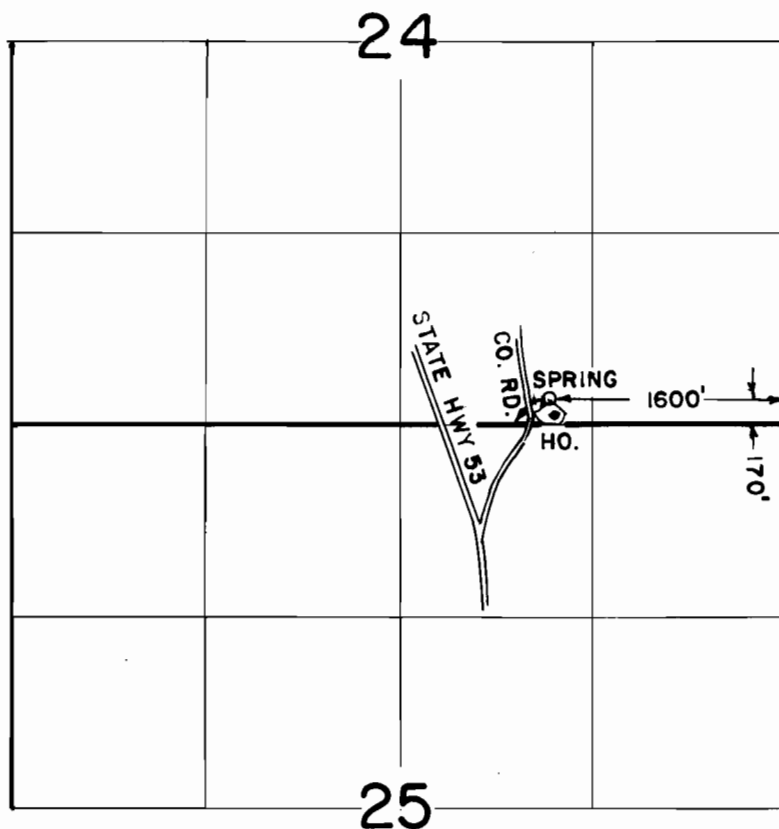

SCALE
1" = 1320'

FINAL PROOF SURVEY
UNDER

Application No. 59231... Permit No. 44397...
IN NAME OF

ELLWOOD D. PALMER

Surveyed MAY 23 1984, by P. PAGTER