


T.2S., R.9W., W. M.

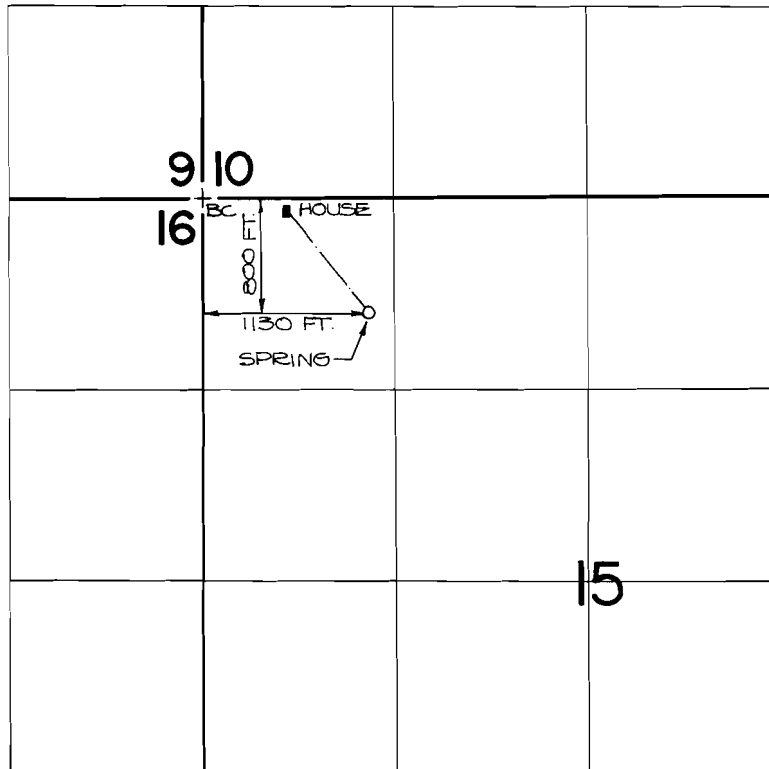


FINAL PROOF SURVEY UNDER

Application No. 58907... Permit No. 44400.....
IN NAME OF

RAY...BAGGARLEY...&...MARK...McVEIGH

Surveyed JULY 31, 1984, by *P. Pagter*.....

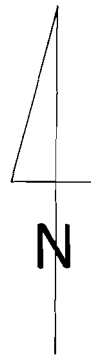

SCALE: 4" = 1 MILE