


T. 1 S. R. 48 E. W. M

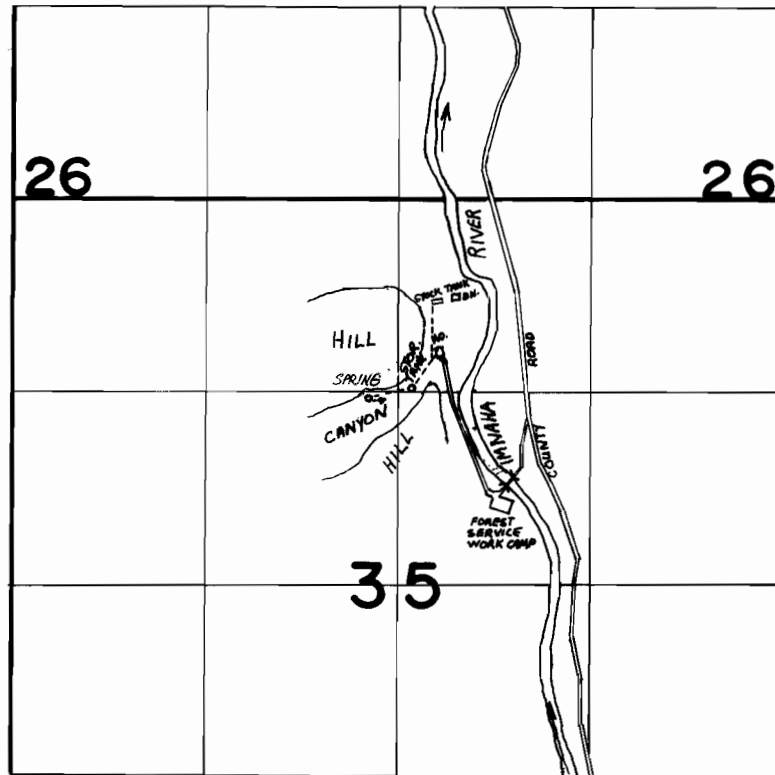

SCALE: 1"=1320'



SPRING LOCATED 1360' S. AND 2840' W. FROM NE. COR. SEC. 35

FINAL PROOF SURVEY UNDER

Application No. 58959 Permit No. 44528.....

IN NAME OF

DONALD D. NORTON.....

Surveyed AUGUST 8, 1984, by V.L. CHURCH.....