


T. 1 S., R. 8 W., W. M.

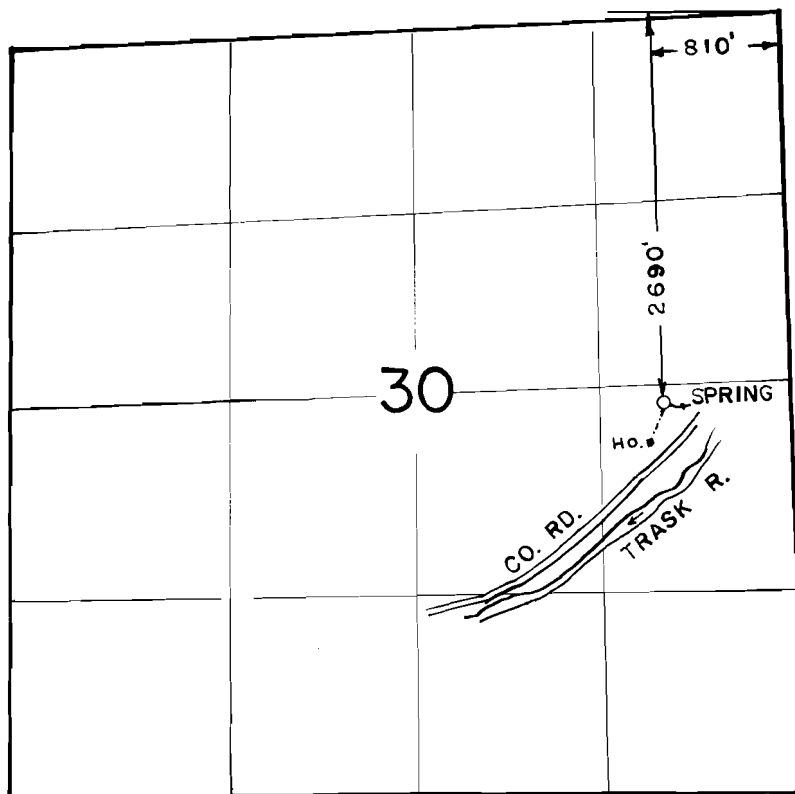

N

SCALE  
1" = 1320'

**FINAL PROOF SURVEY**  
UNDER

Application No. 58806 Permit No. 44588  
IN NAME OF

GEORGE E. HAMILTON

Surveyed JUN 13 1984, by P. PAGTER