


T. 1 N., R. 9 W., W.M.

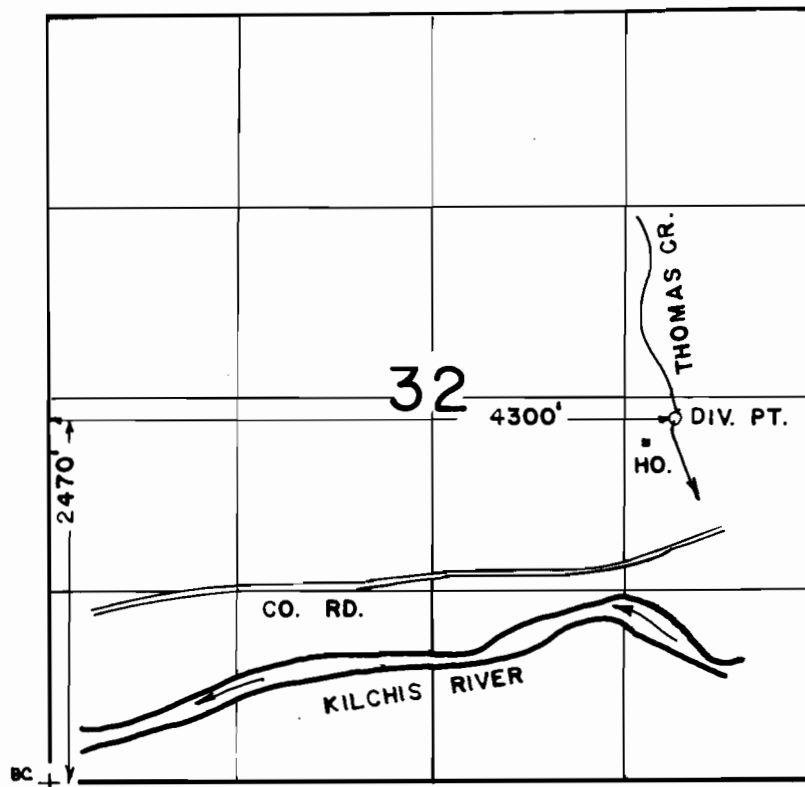

SCALE
1" = 1320'

FINAL PROOF SURVEY
UNDER

Application No. 59327 Permit No. 44591
IN NAME OF

ALBERT & RENEE SHOOK

Surveyed MAY 24, 1984, by P. PAGTER