


T.29S., R.5W., W.M.  
SEC. 32

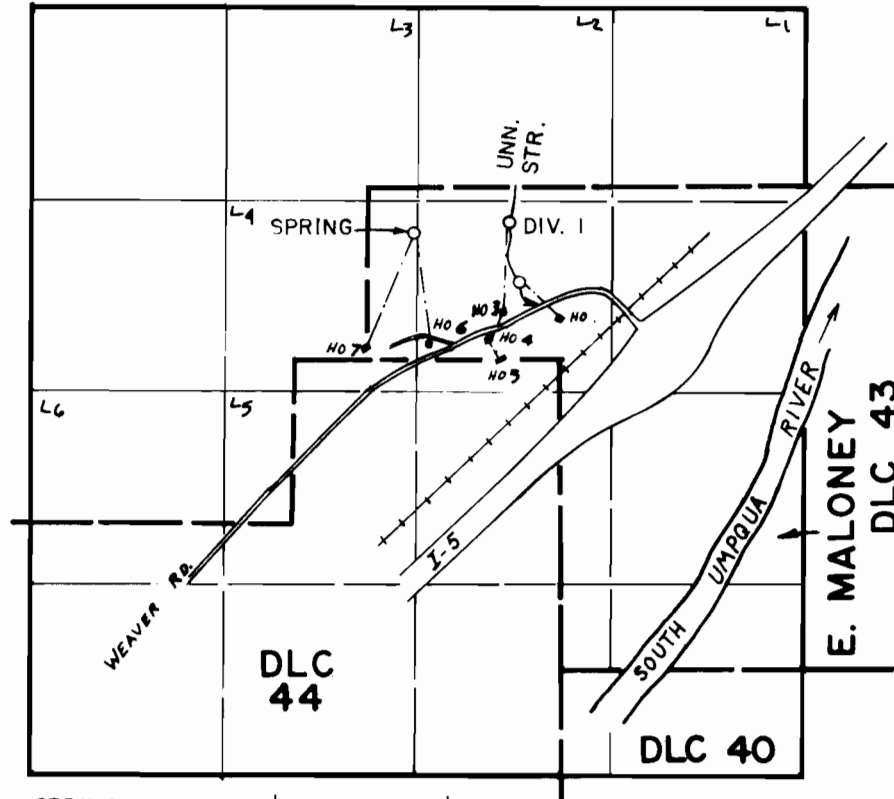

SPRING LOC.: 300' S. and 310' E.

DIV. 1 LOC.: 230' S. and 960' E.

ALL FROM NW COR  
DLC 43.

SCALE: 4" = 1 mile

**FINAL PROOF SURVEY**  
UNDER

Application No. 58649.. Permit No. 44637.....  
IN NAME OF

**WEAVER DISTRICT IMPROVEMENT CO.**

Surveyed MAY...18, 1984, by *L. E. Cashion*