


T.16S.,R.4E.,W.M.

SECTION 24

LOT 2 (NW 1/4 NE 1/4)

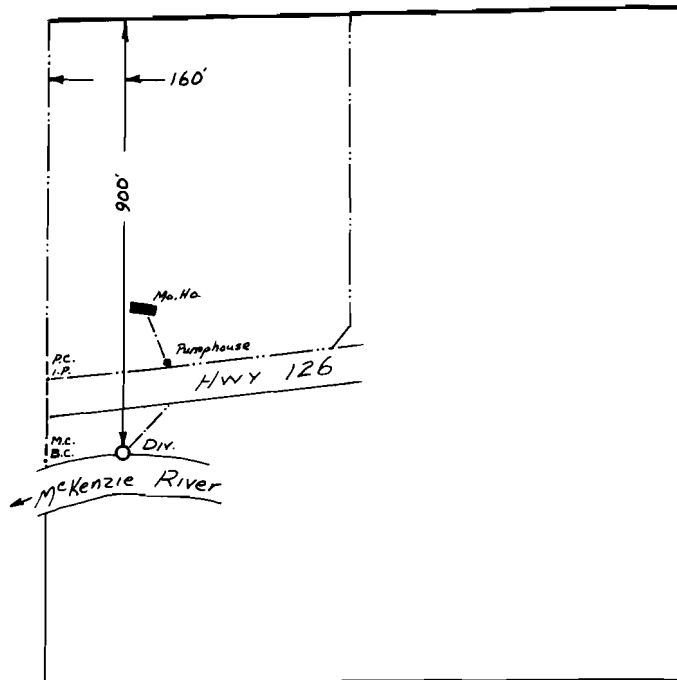

SCALE: 1" = 400'

FINAL PROOF SURVEY
UNDER

Application No. 59814 Permit No. 44862
IN NAME OF

HAROLD E. ALDAL

Surveyed Aug. 20, 1981, by S. C. BROWN