


T.3&4S.,R.8W.,W.M.

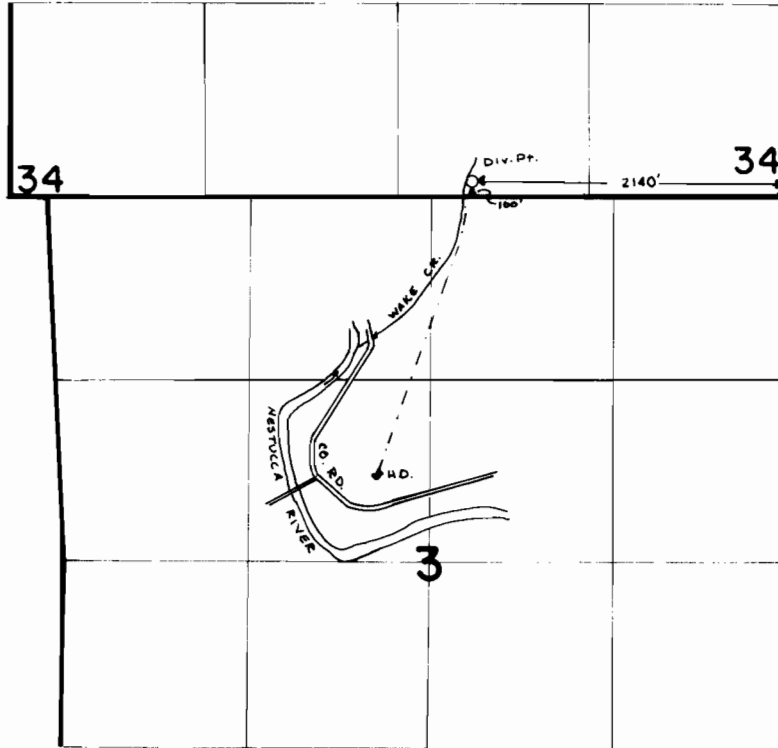

SCALE : 1" = 1320'

FINAL PROOF SURVEY
UNDER

Application No. 59673... Permit No. 44947...
IN NAME OF

S.S. HERR & KENNETH E. LANE

Surveyed SEPT. 12. 19.84, by P. PAGTER.....