


T. 26 S., R. 3 W., W. M.

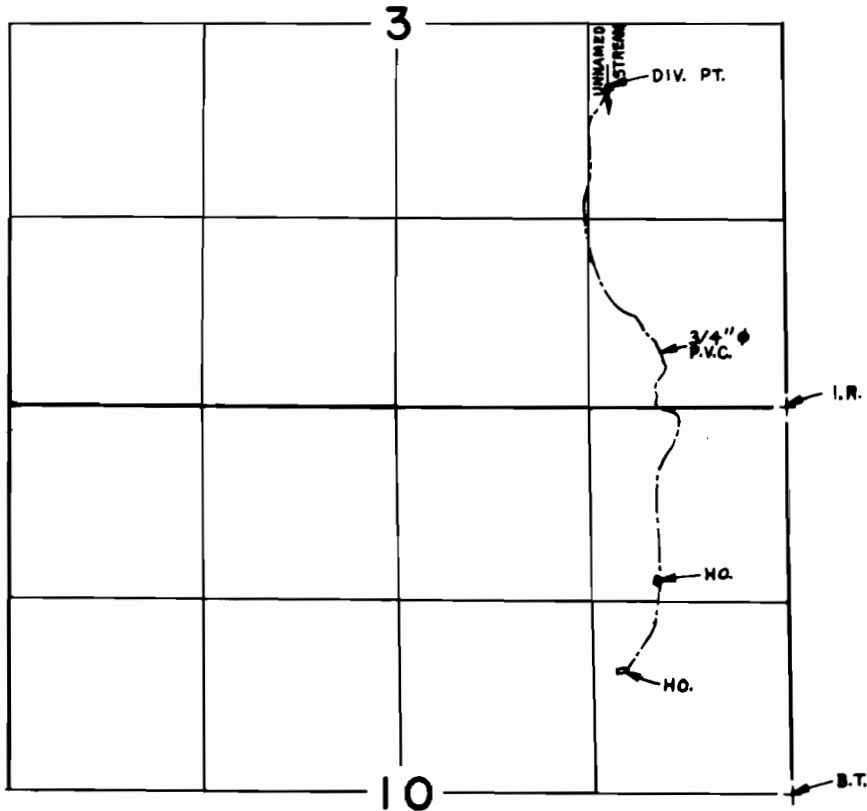

DIV. PT. LOCATED 2,200' N. & 1,228' W. FROM N.E. COR. SEC. 10

SCALE: 4" = 1 mile

FINAL PROOF SURVEY UNDER

Application No. 59182. Permit No. 44991.....
IN NAME OF

.....**DAVID KENNADAY**.....

Surveyed **AUG. 14, 1984**, by **L. CASHION**.....