
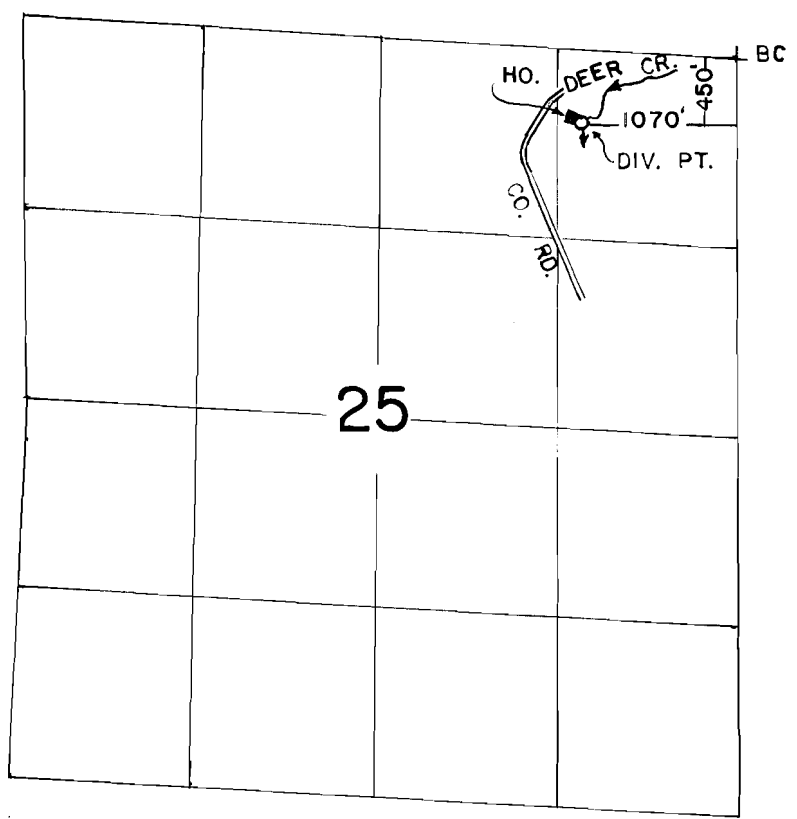


# T. 16 S., R. 9 W., W.M.

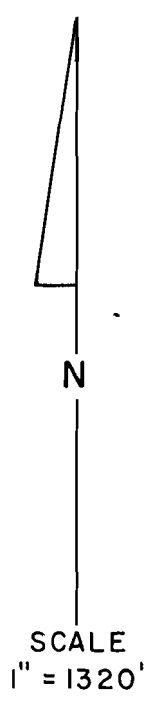

## FINAL PROOF SURVEY UNDER

Application No. 59869 Permit No. 45005  
IN NAME OF

RICHARD GROSS

Surveyed JUN 5 1984, by P. PAGTER