


T. 38 S., R. 8 W., W. M.

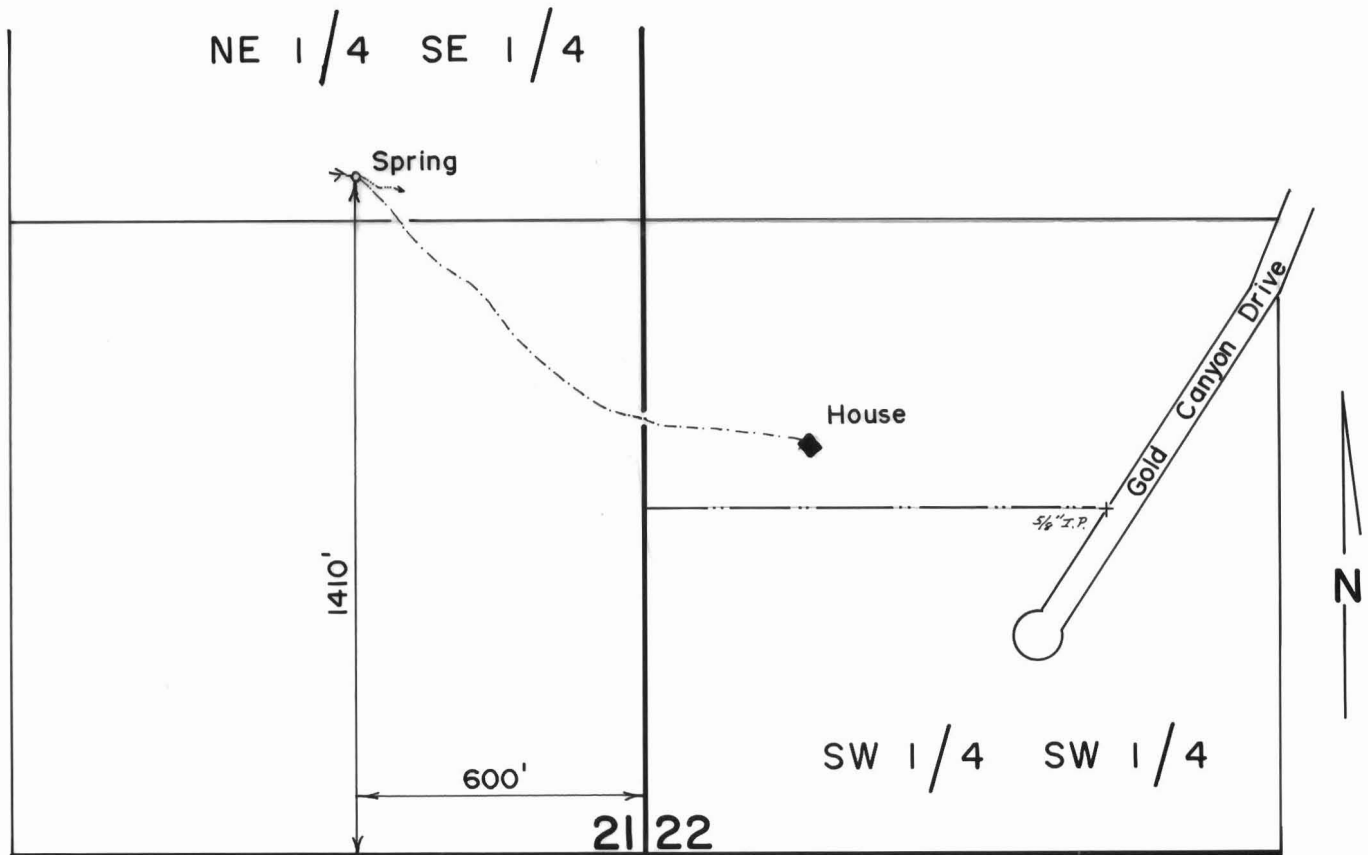

Scale 1" = 400'

FINAL PROOF SURVEY UNDER

Application No. 60069 Permit No. 45065
IN NAME OF

BARRY IVAN NELSON

Surveyed Nov. 7, 1984, by J.R. WOODROOF