


T.26S., R.4W., W.M.

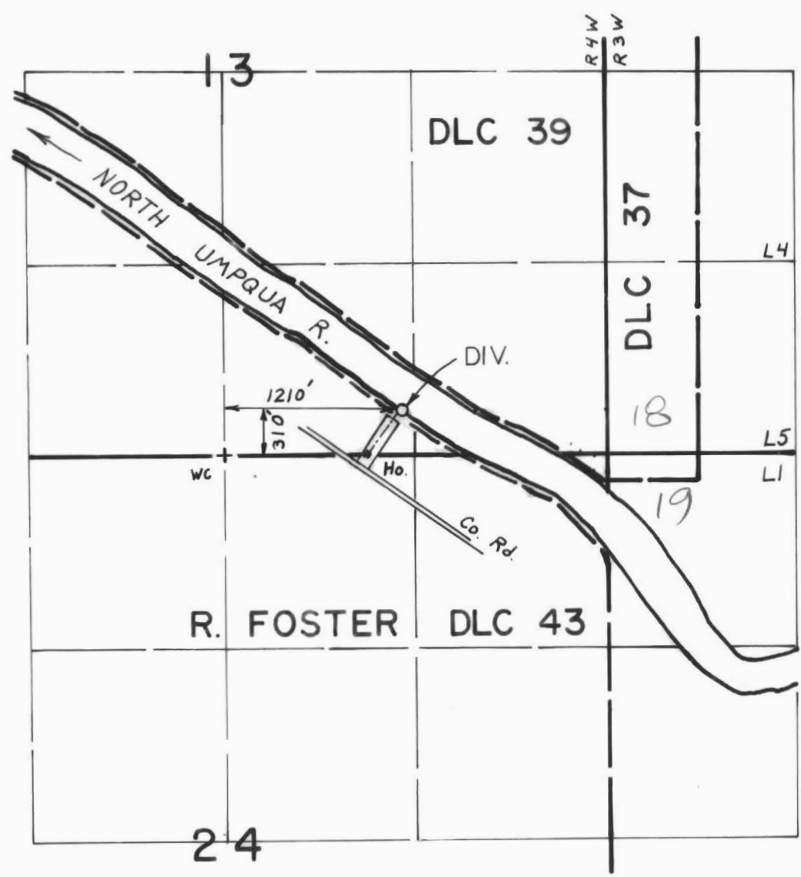

SCALE: 4" = 1 mile

FINAL PROOF SURVEY
UNDER

Application No. ~~60023~~ Permit No. 45072.....
IN NAME OF

KENNETH L. RUSSELL

Surveyed AUG...28 19.84, by *L. Cashion*.....