


T. 26 S., R. 3 W., W.M.

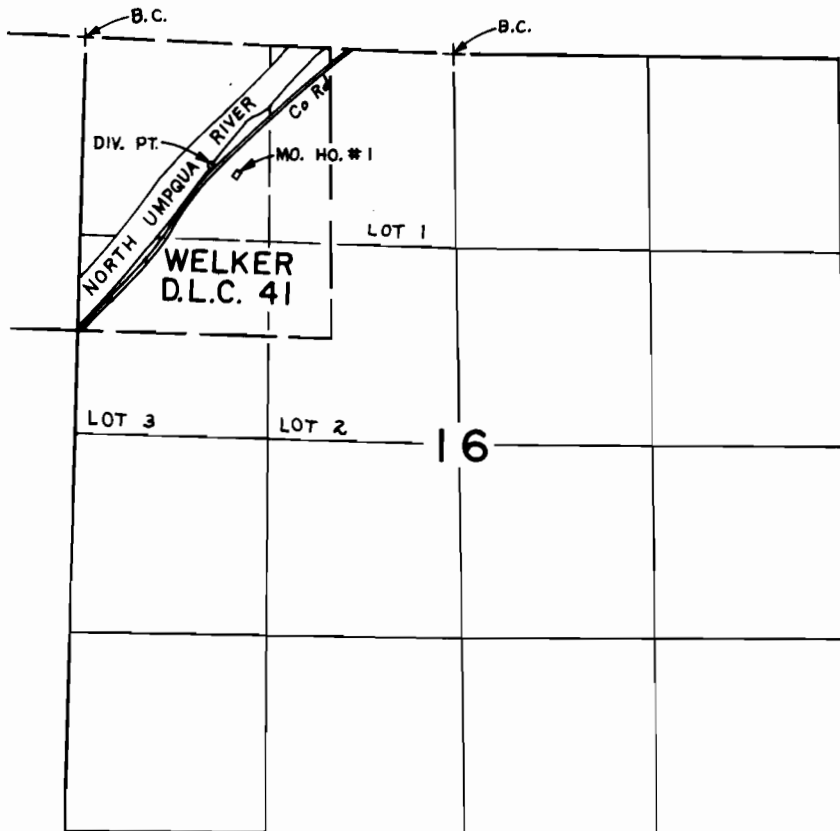

DIV. PT. LOCATED 880'S. & 850'E. FROM N.W. COR. SEC. 16

SCALE: 4" = 1 mile

FINAL PROOF SURVEY UNDER

Application No. ~~60404~~ Permit No. ~~45160~~.....
IN NAME OF

KENNETH L. RILEY.....

Surveyed JUL. 26, 1984, by L. CASHION.....