


T. 3 S., R. 9 W., W.M:

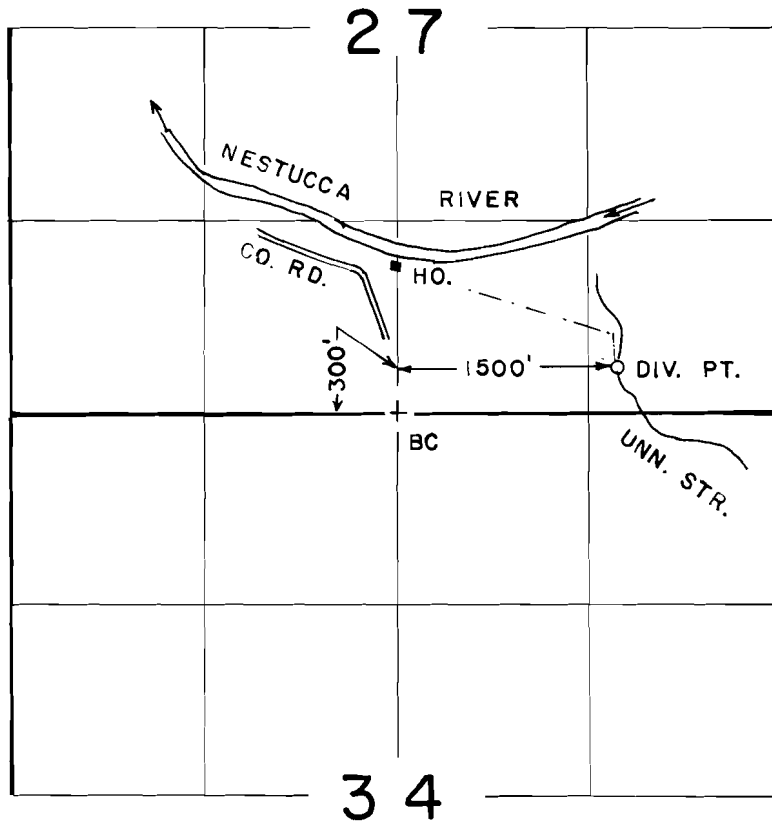

FINAL PROOF SURVEY
UNDER

Application No. 60164 Permit No. 45185
IN NAME OF

ROBERT BRISCOE COLE

Surveyed AUG 1 1984, by P. PAGTER