


T. 6 S., R. 10 W., W.M.

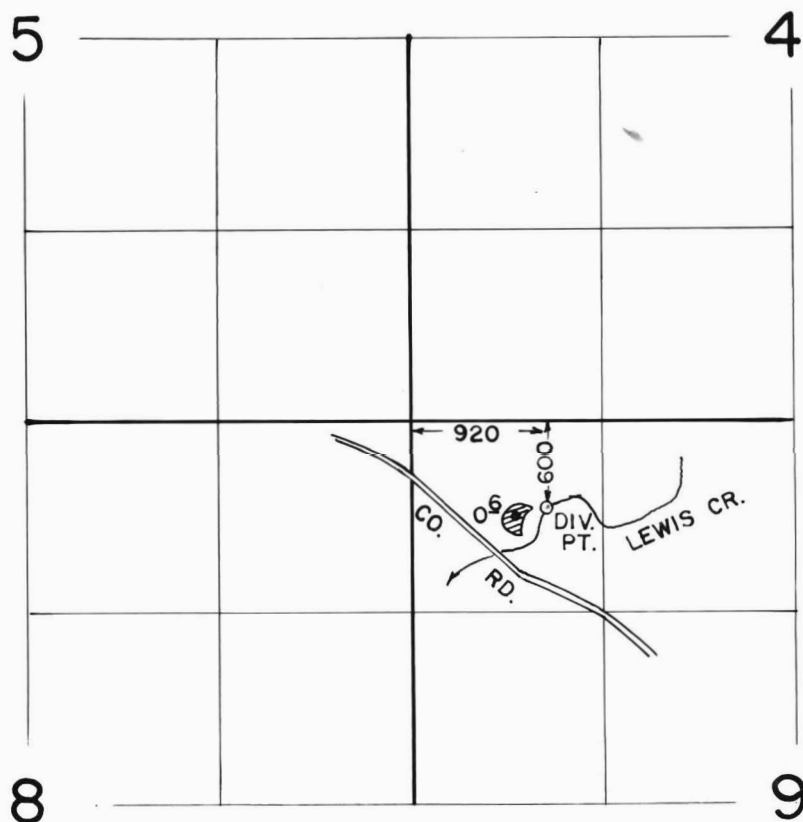

SCALE
1" = 1320'

FINAL PROOF SURVEY
UNDER

Application No. 60582... Permit No. 45280...
IN NAME OF

CAROLYN F. & KATHERINE F. SAUNDERS

Surveyed SEP. 13. 1984, by P. PAGTER