


T.38S., R.8W., W.M.

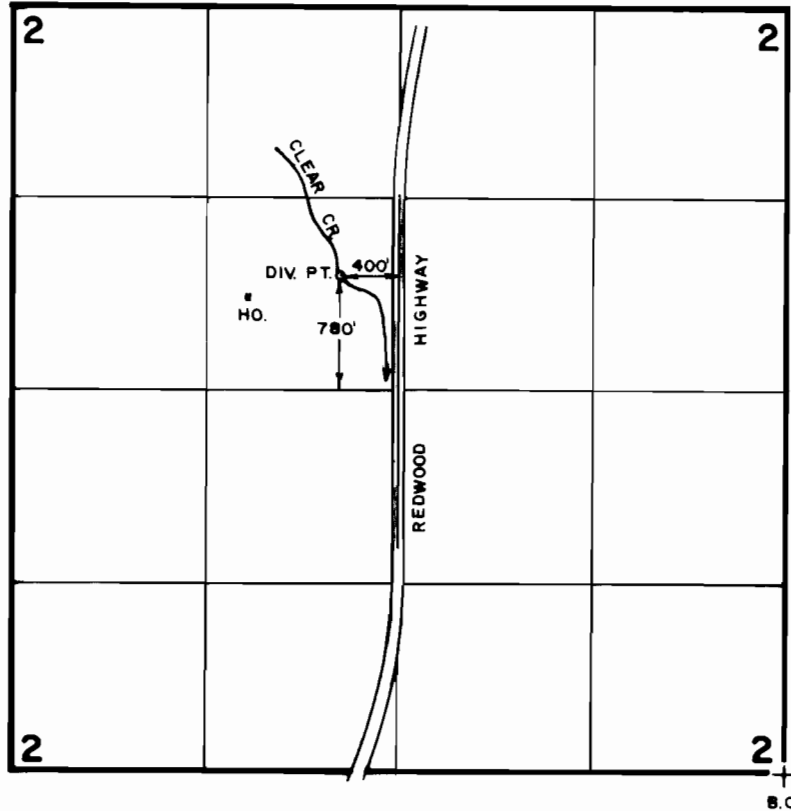

FINAL PROOF SURVEY
UNDER

Application No. 60522 Permit No. 45309
IN NAME OF

JOHN G. FREY

Surveyed OCT. 26 1983, by B.S. JAMES

SCALE: 4" = 1 MILE